

L.A.F. MISSISSIPPI BOARD OF WATER COMMISSIONERS

E 44

4-30-64

WATER WELL DRILLERS LOG

Date: April 30, 1964, Driller: Elliott H. H. County Lafayette  
 (Name)

(1) Owner of Land:	Description & Color of Materials Sand, Clay, Red Clay, Shell, etc.	Thick- ness Feet	Depth Feet
Name: <u>A. C. Tubbs</u>	<u>clay</u>	<u>1</u>	<u>5</u>
Address: <u>Offord</u>	<u>sand</u>	<u>15</u>	<u>20</u>
(2) Location: $\frac{1}{4}$ , $\frac{1}{4}$ , Sec. <u>33</u> T <u>8</u> R <u>4</u>	<u>clay</u>	<u>5</u>	<u>25</u>
1 miles <u>East</u> of <u>Offord</u> , (distance) (direction) (Nearest Town)	<u>sand</u>	<u>19</u>	<u>44</u>
(3) Topography: <u>Flat</u> (Hilly) (Fog) (Level)			
(4) Purpose of Well: <u>Domestic</u> (Domestic Irrigation Municipal, Industrial, Other)			

Information upon completion of well:

(1) Diameter 2 inches.

(2) Total Depth 44 feet.

(3) Water Level 2 feet below top of ground.

(4) Cased to \_\_\_\_\_, Size \_\_\_\_\_.


(5) Screen: Size 2", Length 5'.

(6) Were any formations sealed against pollution?  
 \_\_\_\_\_ yes, \_\_\_\_\_ no.

If YES depth of formation \_\_\_\_\_

Why \_\_\_\_\_

Drillers Remarks: \_\_\_\_\_

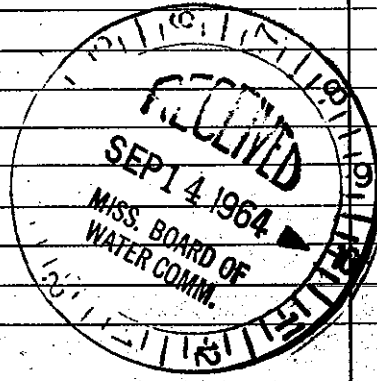

Well No. \_\_\_\_\_

(Use Back Side)

Retain this copy for your office files.