For Office Use Only:

Aquifer:

| Date drilling completed: \$-7-04 | | IS 39289-0631 961-5210 | L. S. Elevation: | |
|--|------------------------------|---|----------------------------|--|
| | (601)354 | 4-6938 (fax) | E-log #: | |
| State Law requires that this report be prepared by the driller in detail and filed with the Department within 30 days of completion of drilling of the well. | | | | |
| Well Owner Informat | tion | Well | Location | |
| Owner Name SHELL GAS MART | | Latitude: <u>34 ° 21 </u> | " Longitude: 89 · 35 · 28" | |
| Mailing Address: Hway 6 West | | Method of Lat/Long (circle on | e): Conventional Survey, | |
| Oxford, | MS | USGS quad, Hand-held | GPS, Survey-grade GPS | |
| City Stat | e Zip Code | SE 14 NW 14 Sec 26 | Twn 85 Rng 4W | |
| Telephone No. (12) 234- | • | Distance Direction Miles | Nearest Town of Oxford | |
| | Well I | Data | | |
| Purpose of Well (circle one) Home Indu | strial Public Supply | Irrigation Fish Culture | Other: CAR WASH | |
| Date well drilling started: $8-5-6$ | Date v | vell drilling completed:S | - 7- 04 | |
| If flowing, method of flow regulation: Valv | ve Other (de | escribe) | | |
| Static Water Level:feet abo | ove or below (circle one) la | and surface Date measured:_ | 8-7-04 | |
| Method of Measurement (circle one) ste | el tape electric tape | air line other: | | |
| Hele depth: /50 / Well depth: /50 / Well grouted to a depth of / O feet | | | | |
| Type of grout (circle one): Cement Bentonite Mix Casing length: / 30 feet Casing diameter: 5" inches Type of casing: Pvc. Screen length: 20 feet Screen diameter: 5" inches Type of screen: 5 19 774 d fvc | | | | |
| Casing length: /30 feet Casing | g diameter: | inches Type of casing: | Prc | |
| Screen length: 20 feet Screen diameter: 5 inches Type of screen: 510772d fuc | | | | |
| Screen slot size: inches Setting depth: From / 30 feet to feet | | | | |
| Type of completion (circle all applicable): Gravel packed Underreamed Telescoped Open hole Natural Development | | | | |
| Other (describe): | | | | |
| Top of lap pipe or reduction in casing:feet. If telescoped or more than one screen, describe on back of page | | | | |
| Logs run (circle all applicable): No log run Electric Gamma Ray Density Sonic Neutron Other: | | | | |
| Name of organization running log(s): | | | | |
| I certify that the well was drilled, constructed, and completed in accordance with all applicable requirements of the Mississippi | | | | |
| Department of Environmental Quality and/or the Mississippi Department of Health regulations and state laws. | | | | |
| LEEPER Drilling 0079 Offen, | | | | |
| Print Name of Water Well Contractor and License No. Signature of Water Well Contractor | | | | |

State Well Report

Part 1 Mississippi Department of Environmental Quality

Office of Land and Water Resources P.O. Box 10631 Jackson, MS 39289-0631


071

RECEIVED

AUG 1 2 2004

BY: OLWP

If well telescopes please sketch below and show depths.

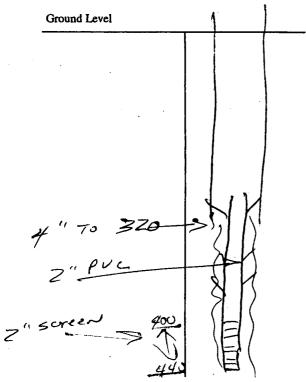

| Description of Formations Encountered | From | То |
|---------------------------------------|------|-----|
| . Dop Clay | 0 | 20 |
| Blue Clay | 20 | 28 |
| CHALK | 280 | 40 |
| Gans | dov | 440 |
| | | |
| | | |
| | | _ |
| | | |
| | | |
| | | |

If more than one screen, show location of each on sketch

| | Sketch the property layo aid in loca 4) indicate | ling the well; 3) any roads, | power lines, or other items the | y permanent structures on the p nat may aid in locating the prop | roperty that may perty and the well; |
|--------|--|------------------------------|---------------------------------|---|--------------------------------------|
| | · | uncetton. | TH- will | / | |
| RECE | VED | | | | |
| AUG 12 | | | | | |
| BY: O | LWR | | | /// | / |
| | . /. | | | | |
| | Landowner Name: | | | | |

STATE WELL REPORT

Part 2

(601)961-5210

Permit #:

Driller:

Permit #:

Driller:

Pump Installer's Completion Report

Mississippi Department of Environmental Quality

Office of Land and Water Resources

P.O. Box 10631

Jackson, MS 39289-0631

Date completed:

| For Office Use Only: | | |
|----------------------|--|--|
| Aquifer: | | |
| Well #: <u>E69</u> | | |
| Elevation: | | |

| (6 | 601)354-6938 (fax) Elevation: | | |
|---|---|--|--|
| This report should be prepared by the pump installer in installation of pump. | n detail and filed with the Department within 30 days of the | | |
| Well Owner Information | Well Location | | |
| Owner Name: SHELL GAS MAY 7 | Latitude:Longitude: | | |
| Mailing Address: Hiway 6 West Oxford MS | Method of Lat/Long (circle one): Conventional Survey, USGS quad, Hand-held GPS, Survey-grade GPS | | |
| City State Zip Code Telephone No. (65 234-5422 | | | |
| Pump Type Circle one | Power Type Circle one | | |
| Air Lift Jet Submersible | Diesel Engine Gasoline Engine Natural Gas | | |
| Bucket Piston Turbine | Electric Motor Hand Tractor PTO | | |
| Centrifugal Rotary Flowing Well | Windmill Other (specify): | | |
| Other (specify): | Horse Power Rating of Motor: 5 HP | | |
| Date Pump Installed: $8-9-04$ | Setting Depth:feet | | |
| Rated Pump Capacity:Gallons Per Minut | te Number of Stages:/ & | | |
| Pump Test Data Date Well Tested: | Method of Measuring Water Level Circle one | | |
| Static Water Level (A):Feet Below Land Surface Pumping Water Level (B):Feet Below Land Surface | Other (specify): | | |
| Drawdown [(B) - (A)]:Feet Below Land Surface | For flowing well, measured shut in head:feet | | |
| Test Pumping Rate:Gallons Per Minute | Well yieldedGPM with a drawdown of | | |
| Duration of Pump Test (minimum 4 hours):hours | feet afterhours of pumping | | |
| | | | |
| I HEREBY CERTIFY that the above statements are true to the LEFER Drilliam CO79 Print Name of Fump Installer and License No. (if applicable) | best of my knowledge Signature of Pump Installer | | |

RECEIVE

AUG 1 2 2004

BY: OI WR