

State Well Report

Part 1

Mississippi Department of Environmental Quality
Office of Land and Water Resources
P.O. Box 10631
Jackson, MS 39289-0631
(601)961-5210
(601)354-6938 (fax)

For Office Use Only:

Aquifer: _____
Well #: E-101
L. S. Elevation: _____
E-log #: _____

County: Lafayette
Permit #: _____
Driller: Leeper Drilling
Date drilling completed: 12-18-07

State Law requires that this report be prepared by the driller in detail and filed with the Department within 30 days of completion of drilling of the well.

Well Owner Information

Owner Name: Andy Fotena
Mailing Address: Lot # 8
CR 149
Oxford MS 38865
City State Zip Code
Telephone No. (601) 310-1225

Well Location

Latitude: _____° _____' _____" Longitude: _____° _____' _____"
Method of Lat/Long (circle one): Conventional Survey, _____
USGS quad, Hand-held GPS, Survey-grade GPS
_____ 1/4 _____ 1/4 Sec 4 Twn 85 Rng 4W
Distance Direction Nearest Town
3 Miles W of Oxford

Well Data

Purpose of Well (circle one) Home Industrial Public Supply Irrigation Fish Culture Other: _____
Date well drilling started: 12-18-07 Date well drilling completed: 12-18-07
If flowing, method of flow regulation: Valve _____ Other (describe) _____
Static Water Level: 90 feet above of below (circle one) land surface Date measured: 12-19-07
Method of Measurement (circle one) steel tape electric tape air line other: _____
Hole depth: 170 ft Well depth: 170 ft Well grouted to a depth of 10 feet
Type of grout (circle one): Cement Bentonite Mix
Casing length: 155 feet Casing diameter: 4" inches Type of casing: PVC
Screen length: 15 feet Screen diameter: 4" inches Type of screen: PVC
Screen slot size: .013 inches Setting depth: From 155 feet to 170 feet
Type of completion (circle all applicable): Gravel packed Underreamed Telescoped Open hole Natural Development
Other (describe): _____
Top of lap pipe or reduction in casing: _____ feet. If telescoped or more than one screen, describe on back of page
Logs run (circle all applicable): No log run Electric Gamma Ray Density Sonic Neutron Other: _____

Name of organization running log(s): _____

I certify that the well was drilled, constructed, and completed in accordance with all applicable requirements of the Mississippi Department of Environmental Quality and/or the Mississippi Department of Health regulations and state laws.

Leeper Drilling #0079

Print Name of Water Well Contractor and License No.

Signature of Water Well Contractor


RECEIVED

JAN 02 2008

BY: OLWR

If well telescopes please sketch below and show depths.


E 101

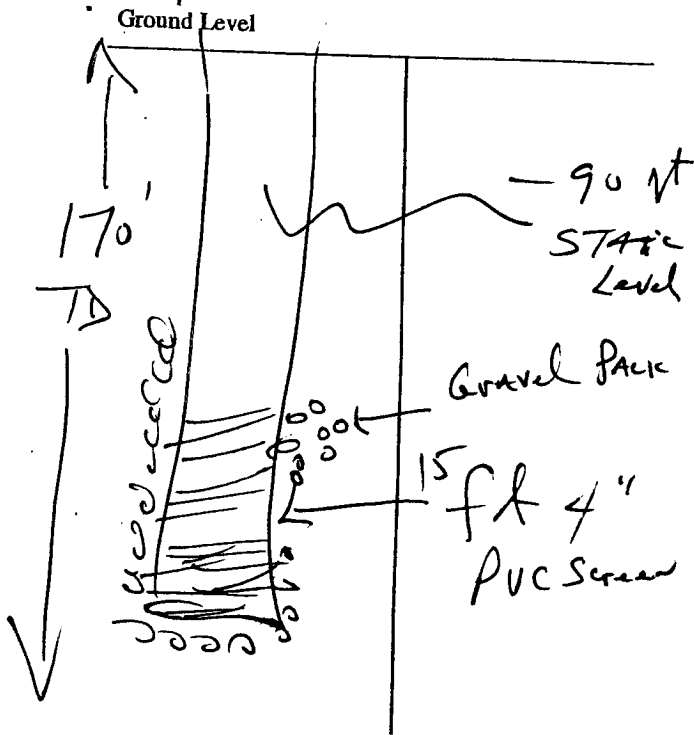

Description of Formations Encountered	From	To
T.P. clay	0	10
Red Sand	10	25
Brown Sand	25	100
White Sand	100	170

If more than one screen, show location of each on sketch

Sketch the property layout and include the following: 1) the well location; 2) any permanent structures on the property that may aid in locating the well; 3) any roads, power lines, or other items that may aid in locating the property and the well; 4) indicate direction.

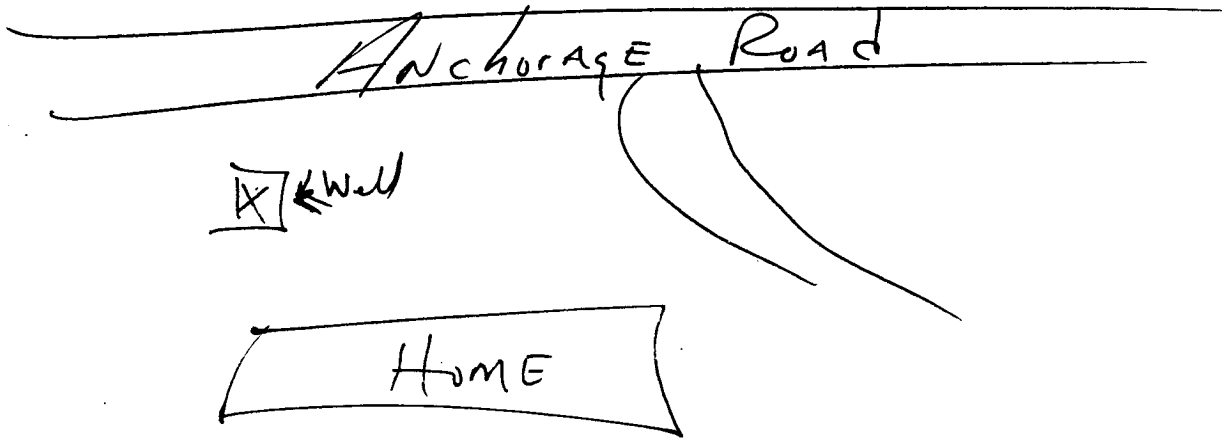

Landowner Name: Andy Fotena

Signature of Water Well Contractor [Signature]

RECEIVED
JAN 02 2008
BY: OLWF

STATE WELL REPORT

Part 2

Pump Installer's Completion Report
 Mississippi Department of Environmental Quality
 Office of Land and Water Resources
 P.O. Box 10631
 Jackson, MS 39289-0631
 (601)961-5210
 (601)354-6938 (fax)

For Office Use Only:

Aquifer: _____
 Well #: E 101
 Elevation: _____

County: Lafayette
 Permit #: _____
 Driller: Leeper Drilling
 Date completed: 12-19-07

This report should be prepared by the pump installer in detail and filed with the Department within 30 days of the installation of pump.

Well Owner Information	Well Location
Owner Name: <u>Andy Fojana</u>	Latitude: _____ Longitude: _____
Mailing Address: <u>Lot #8</u>	Method of Lat/Long (circle one): <input type="radio"/> Conventional Survey,
<u>CR 149</u>	<input type="radio"/> USGS quad, Hand-held GPS, Survey-grade GPS
<u>Oxford, MS 38865</u>	<u>1/4</u> <u>1/4</u> Sec <u>4</u> Twn <u>8S</u> Rng <u>4W</u>
City State Zip Code	Distance Direction Nearest Town
Telephone No. <u>(601) 310-1225</u>	<u>3</u> Miles <u>W</u> of <u>Oxford</u>

Pump Type Circle one	Power Type Circle one
Air Lift <input type="radio"/> Jet <input checked="" type="radio"/> <u>Submersible</u>	Diesel Engine <input type="radio"/> Gasoline Engine <input type="radio"/> Natural Gas <input type="radio"/>
Bucket <input type="radio"/> Piston <input type="radio"/> Turbine <input type="radio"/>	<u>Electric Motor</u> <input checked="" type="radio"/> Hand <input type="radio"/> Tractor PTO <input type="radio"/>
Centrifugal <input type="radio"/> Rotary <input type="radio"/> Flowing Well <input type="radio"/>	Windmill <input type="radio"/> Other (specify): _____
Other (specify): _____	Horse Power Rating of Motor: <u>3/4 HP</u>
Date Pump Installed: <u>12-19-07</u>	Setting Depth: <u>140</u> feet
Rated Pump Capacity: <u>10</u> Gallons Per Minute	Number of Stages: <u>11</u>

Pump Test Data	Method of Measuring Water Level Circle one
Date Well Tested: <u>12-19-07</u>	Air Line <input type="radio"/> Electric Measuring Line <input type="radio"/> <u>Steel Tape</u> <input checked="" type="radio"/>
Static Water Level (A): <u>90</u> Feet Below Land Surface	Other (specify): _____
Pumping Water Level (B): _____ Feet Below Land Surface	For flowing well, measured shut in head: _____ feet
Drawdown [(B) - (A)]: _____ Feet Below Land Surface	Well yielded _____ GPM with a drawdown of _____ feet after _____ hours of pumping
Test Pumping Rate: _____ Gallons Per Minute	
Duration of Pump Test (minimum 4 hours): _____ hours	

I HEREBY CERTIFY that the above statements are true to the best of my knowledge.

Leeper Drilling #0079 _____
 Print Name of Pump Installer and License No. (if applicable) Signature of Pump Installer

RECEIVED
 JAN 02 2008
 BY: OIWE