

State Well Report

Part 1

Mississippi Department of Environmental Quality
Office of Land and Water Resources
P.O. Box 10631
Jackson, MS 39289-0631
(601)961-5210
(601)354-6938 (fax)

For Office Use Only:

Aquifer: _____
Well #: E-104
L. S. Elevation: _____
E-log #: _____

County: La Fayette
Permit #: _____
Driller: Leeper Drilling
Date drilling completed: 1-18-08

State Law requires that this report be prepared by the driller in detail and filed with the Department within 30 days of completion of drilling of the well.

| Well Owner Information | Well Location |
|--|--|
| Owner Name: <u>ERA Realty</u> | Latitude: _____ Longitude: _____ |
| Mailing Address: <u>500 Jackson Ave E.</u> | Method of Lat/Long (circle one): Conventional Survey, USGS quad, Hand-held GPS, Survey-grade GPS |
| <u>Oxford MS 38865</u> | _____ 1/4 _____ 1/4 Sec <u>13</u> Twn <u>8S</u> Rng <u>4W</u> |
| City _____ State _____ Zip Code _____ | Distance _____ Direction _____ Nearest Town _____ |
| Telephone No. <u>(662) 234-8404</u> | <u>2</u> Miles <u>W</u> of <u>Oxford</u> |

Well Data

Purpose of Well (circle one) Home Industrial Public Supply Irrigation Fish Culture Other: _____

Date well drilling started: 1-18-08 Date well drilling completed: 1-18-08

If flowing, method of flow regulation: Valve _____ Other (describe) _____

Static Water Level: 85 feet above or below (circle one) land surface Date measured: 1-19-08

Method of Measurement (circle one) steel tape electric tape air line other: _____

Hole depth: 170 ft Well depth: 170 ft Well grouted to a depth of 10 feet

Type of grout (circle one): Cement Bentonite Mix

Casing length: 155 feet Casing diameter: 4 inches Type of casing: PVC

Screen length: 15 feet Screen diameter: 4 inches Type of screen: PVC

Screen slot size: .013 inches Setting depth: From 155 feet to 170 feet

Type of completion (circle all applicable): Gravel packed Underreamed Telescoped Open hole Natural Development
Other (describe): _____


Top of lap pipe or reduction in casing: _____ feet. If telescoped or more than one screen, describe on back of page

Logs run (circle all applicable): No log run Electric Gamma Ray Density Sonic Neutron Other: _____

Name of organization running log(s): _____

I certify that the well was drilled, constructed, and completed in accordance with all applicable requirements of the Mississippi Department of Environmental Quality and/or the Mississippi Department of Health regulations and state laws.



Leeper Drilling # 0079
Print Name of Water Well Contractor and License No.

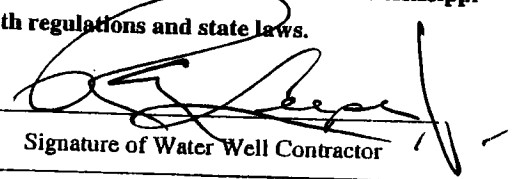
Signature of Water Well Contractor

RECEIVED
FEB 04 2008
BY: OLWR

E-104


If well telescopes please sketch below and show depths.

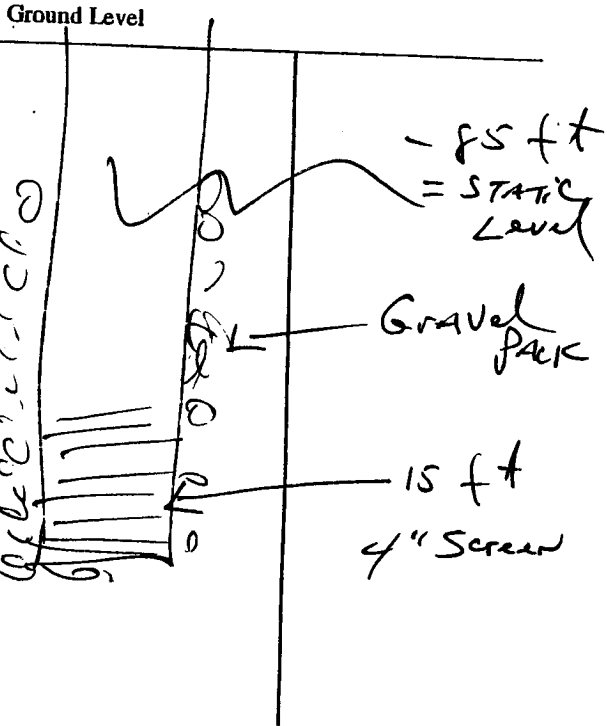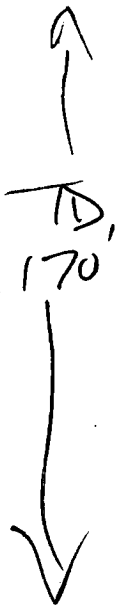

| Description of Formations Encountered | From | To |
|---------------------------------------|------|-----|
| Red Clay | 0 | 5 |
| Red sand | 5 | 80 |
| White Sand | 80 | 170 |
| | | |
| | | |
If more than one screen, show location of each on sketch

Sketch the property layout and include the following: 1) the well location; 2) any permanent structures on the property that may aid in locating the well; 3) any roads, power lines, or other items that may aid in locating the property and the well; 4) indicate direction.

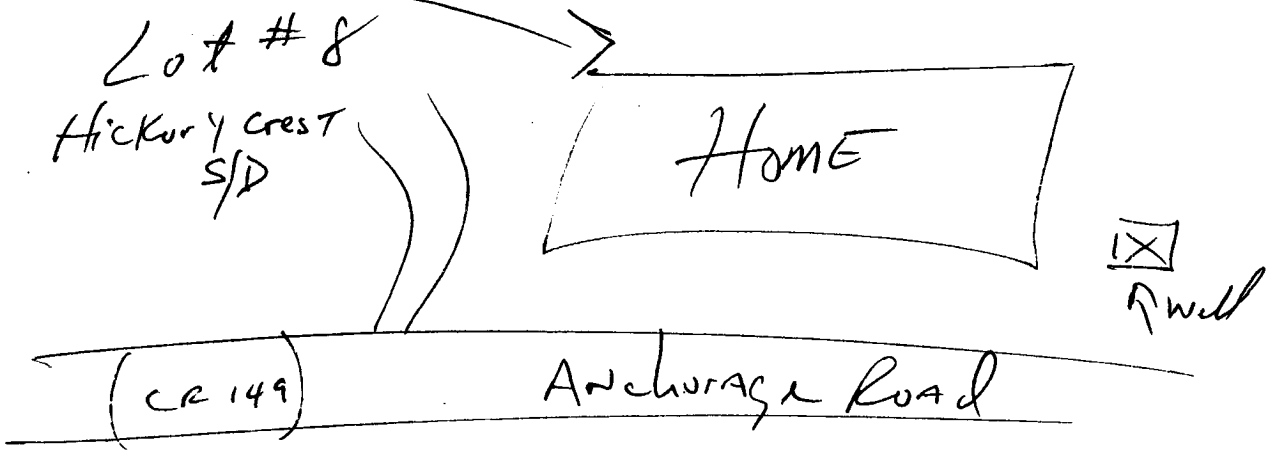

Landowner Name: ERA Realty

[Signature]
Signature of Water Well Contractor

RECEIVED
FEB 04 2008
BY: OLWR

STATE WELL REPORT

Part 2

Pump Installer's Completion Report
 Mississippi Department of Environmental Quality
 Office of Land and Water Resources
 P.O. Box 10631
 Jackson, MS 39289-0631
 (601)961-5210
 (601)354-6938 (fax)

For Office Use Only:

Aquifer: _____
 Well #: E-104
 Elevation: _____

County: Lafayette
 Permit #: _____
 Driller: Leeper Drilling
 Date completed: 1-19-08

This report should be prepared by the pump installer in detail and filed with the Department within 30 days of the installation of pump.

| Well Owner Information | Well Location |
|--|---|
| Owner Name: <u>ERA Realty</u> | Latitude: _____ Longitude: _____ |
| Mailing Address: <u>500 Jackson Ave E.</u> | Method of Lat/Long (circle one): Conventional Survey, |
| <u>Oxford</u> <u>MS</u> <u>38605</u> | USGS quad, Hand-held GPS, Survey-grade GPS |
| City State Zip Code | _____ 1/4 _____ 1/4 Sec <u>13</u> Twn <u>8 S</u> Rng <u>4 W</u> |
| Telephone No. <u>(662) 234-8404</u> | Distance Direction Nearest Town |
| | <u>2</u> Miles <u>W</u> of <u>Oxford</u> |

| Pump Type Circle one | Power Type Circle one |
|---|--|
| Air Lift Jet <input type="radio"/> <u>Submersible</u> | Diesel Engine Gasoline Engine Natural Gas |
| Bucket Piston <input type="radio"/> Turbine | <u>Electric Motor</u> Hand Tractor PTO |
| Centrifugal Rotary <input type="radio"/> Flowing Well | Windmill Other (specify): _____ |
| Other (specify): _____ | Horse Power Rating of Motor: <u>3/4 HP</u> |
| Date Pump Installed: <u>1-19-08</u> | Setting Depth: <u>130</u> feet |
| Rated Pump Capacity: <u>10</u> Gallons Per Minute | Number of Stages: <u>11</u> |

| Pump Test Data | Method of Measuring Water Level Circle one |
|---|---|
| Date Well Tested: <u>1-19-08</u> | Air Line Electric Measuring Line <u>Steel Tape</u> |
| Static Water Level (A): <u>85</u> Feet Below Land Surface | Other (specify): _____ |
| Pumping Water Level (B): _____ Feet Below Land Surface | For flowing well, measured shut in head: _____ feet |
| Drawdown [(B) - (A)]: _____ Feet Below Land Surface | Well yielded _____ GPM with a drawdown of |
| Test Pumping Rate: _____ Gallons Per Minute | _____ feet after _____ hours of pumping |
| Duration of Pump Test (minimum 4 hours): _____ hours | |

I HEREBY CERTIFY that the above statements are true to the best of my knowledge.

Leeper Drilling #0079 _____
 Print Name of Pump Installer and License No. (if applicable) Signature of Pump Installer

RECEIVED
 FEB 04 2008
 BY: OLWR