
	State Well Report	
County: A-Allette	Part 1	For Office Use Only:
	opi Department of Environmental Qualit	
Or Or	flice of Land and Water Resources	(107
Driller: Drilling	P.O. Box 10631	Well #: <u>C - 101</u>
Date drilling completed:	Jackson, MS 39289-0631	L. S. Elevation:
	(601)961-5210 (601)354-6938 (fax)	
State Levense in the second		E-log #:
State Law requires that this report be pre- 30 days of completion of drilling of the wel Well Owner Information	pared by the driller in detail and filed	with the Department within
Well Owner Information		/ell Location
Owner Name Keijstone Co ++		
		" Longitude:"
	method of LavLong (circle	one): Conventional Survey,
164 Cyprine (USGS quad, Hand-he	eld GPS, Survey-grade GPS
City State Ti		3 Twn 85 Rng 4W
Telephone No. (662) 236- 5087	Distance Direction	Manual
		_01_0× //
Durnana CWV 11 / /	Well Data	1
Purpose of Well (circle one) Home Industrial Pu	blic Supply Irrigation Fish Culture	Other: HATMENT S
Date well drilling started: <u>5-8-08</u>		S-8-
If flowing, method of flow regulation: Valve	• Other (describe)	
Static Water Level:		
Static Water Level:feet above of below	(circle one) land surface Date measured	5-9-04
Method of Measurement (circle one) Steel tape		
	70 Well grouted to a depth of	forfeet
Type of grout (circle one): Cement Bentonite		-
Casing length:feet Casing diameter:		Pvc
	/ ijpe or easing:	A
		puc
Screen slot size: . 013 inches Setting de	epth: Fromfeet to	7 U feet
Type of completion (circle all applicable)/ Gravel packet		
•		Private
Other (desc	cribe):	
Fop of lap pipe or reduction in casing:	feet. If telescoped or more than any	
Logs run (circle all applicable): No log run Electric (Gamma Ray Density Gatt	een, describe on back of page
	Source Neutron	Other:
Name of organization mention less ()		1
Name of organization minning log(s).		
certify that the well was drilled, constructed, and con	mpleted in accordance with all applicable	requirements of the Mississippi
certify that the well was drilled, constructed, and con Department of Environmental Quality and/or the Miss	mpleted in accordance with all applicable is sissippi Department of Health regulations	requirements of the Mississippi and state laws.
certify that the well was drilled, constructed, and con	mpleted in accordance with all applicable is sissippi Department of Health regulations	requirements of the Mississippi and state laws.
certify that the well was drilled, constructed, and con Department of Environmental Quality and/or the Miss	sissippi Department of Health regulations	regulrements of the Mississippi and state laws. Water Well Contractor

1

L

MAY 1.5 2008 BY: OLW R If well telescopes please sketch below and show depths.

E-10]

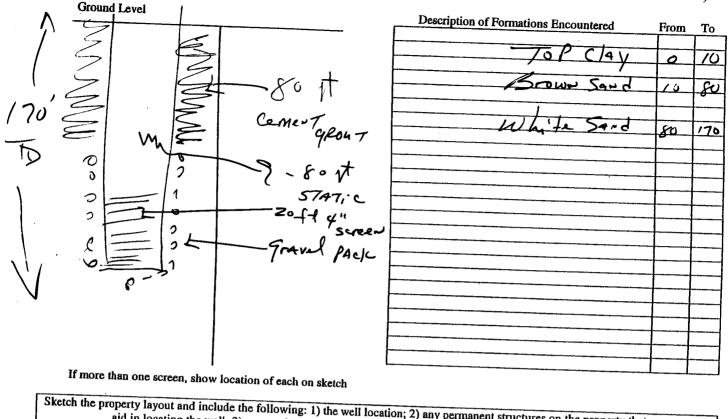

aid in locating the well; 3) any roa 4) indicate direction.	ids, power lines, or other items that may aid in locating the property and the well;
	Well # 2
	L XXXXXXXXXXXXXXXXXXXXXXXXXXXXXXXXXXXX
	Archurage Road
Landowner Name: 5 Key	STONE Cottages
Signature of Water Well Contractor	

MAY 1 5 2008 BY: OLWR

×	0		
	J STATE V	VELL REPORT	
County: LA FAYETTE	Part 2		For Operation
Permit #:	Pump Installer's Completion Report Mississippi Department of Environmental Quality		For Office Use Only:
Driller: Leeper Dr. 1/1,29	Unice of Lai	nd and Water Resources	Aquifer:
· · · · · · · · · · · · · · · · · · ·	Jacksor	O. Box 10631 1, MS 39289-0631	Well #: 5-107
Date completed: 5-9-08	(6)	01)961-5210	
This report should be prepared by the] (001))354-6938 (fax)	Elevation:
This report should be prepared by th installation of pump.	e pump installer in de	etail and filed with the Departmen	t within 30 days of the
then Owner Information	tion T	71	Location
Owner Name: Keystone	In Hagen		
Mailing Address: c/e Rick C	Ardunl	Latitude: Longitude:	
		Method of Lat/Long (circle one	e): Conventional Survey,
OXCIA	Arm Circly	USGS quad, Hand-	held GPS, Survey-grade GPS
City /State	3 38655		Twn_ & S _{Rng} 4 W
	Zip Code		
Telephone No. (202) 236- 20	: 87	Diccion	Nearest Town
		Miles Wint of	Oxford
Ритр Туре		1	
Circle one			er Type le one
Air Lift Jet	Submersible		
Bucket Piston –			Engine Natural Gas
Cent-if	Turbine	Electric Motor Hand	Tractor PTO
	Flowing Well	Windmill Other (sp	ecify):
Other (specify):			
Date Pump Installed: 5 - 5 - 0 \$ Rated Pump Capacity: Gallons Per Minute		Horse Power Rating of Motor: <u>3</u> HP Setting Depth: <u>120</u> feet	
Pump Test Data		/	
Date Well Tested:		Method of Measu	ring Water Level
		Circle one	
Static Water Level (A):Fee Be		Electric Measuri	ng Line (Steel Tape)
Pumping Water Level (B):Feet Bel	low Land Surface	Other (specify):	
Drawdown [(B) – (A)]:Feet Be		R d. · ·	
Test Pumping Rate:Ga		For flowing well, measured shut in	
		Well yieldedG	PM with a drawdown of
Duration of Pump Test (minimum 4 hours):	hours	feet after	hours of pumping
	l		
HEREBY CERTIFY that the above statement	is are true to the best of	my knowled	0 1
Leeper Vrilling 7	#007G	my knowledge.	7
Print Name of Pump Installer and License No.	(if applicable)	Signature of Pump Install	eer /
		Signature of Pump Install	
			RECEIVE
			MAY 15 200
			BY: OLW