

# State Well Report

## Part 1

Mississippi Department of Environmental Quality  
Office of Land and Water Resources  
P.O. Box 10631  
Jackson, MS 39289-0631  
(601)961-5210  
(601)354-6938 (fax)

For Office Use Only:

Aquifer: E 119  
Well #: \_\_\_\_\_  
L. S. Elevation: \_\_\_\_\_  
E-log #: \_\_\_\_\_

County: Lafayette  
Permit #: \_\_\_\_\_  
Driller: LEEPER Drilling  
Date drilling completed: 11-17-11

State Law requires that this report be prepared by the driller in detail and filed with the Department within 30 days of completion of drilling of the well.

### Well Owner Information

Owner Name: Greg Bursavich  
Mailing Address: CR 1069  
Oxford, MS 38655  
City State Zip Code  
Telephone No. (225) 813-6210

### Well Location

Latitude: 34° 22' 28" N Longitude: 89° 41' 67" W  
Method of Lat/Long (circle one): Hand-held GPS, Survey-grade GPS  
USGS quad: 13  
NW 1/4 SE Sec 26 Twn 85 Rng 5W  
Distance 11 Miles Direction W of Nearest Town Oxford

### Well Data

Purpose of Well (circle one): Home Industrial Public Supply Irrigation Fish Culture Other: \_\_\_\_\_  
Date well drilling started: 11-17-11 Date well drilling completed: 11-17-11  
If flowing, method of flow regulation: Valve \_\_\_\_\_ Other (describe) \_\_\_\_\_  
Static Water Level: 150 feet above or below (circle one) land surface Date measured: 11-18-11  
Method of Measurement (circle one): steel tape electric tape air line other: \_\_\_\_\_  
Hole depth: 210 ft Well depth: 210 ft Well grouted to a depth of 10 feet  
Type of grout (circle one): Cement Bentonite Mix  
Casing length: 190 feet Casing diameter: 4" inches Type of casing: PVC  
Screen length: 20 feet Screen diameter: 4" inches Type of screen: PVC  
Screen slot size: .010 inches Setting depth: From 190 feet to 210 feet  
Type of completion (circle all applicable): Gravel packed Underreamed Telescoped Open hole Natural Development  
Other (describe): \_\_\_\_\_  
Top of lap pipe or reduction in casing: \_\_\_\_\_ feet. If telescoped or more than one screen, describe on back of page  
Logs run (circle all applicable): No log run Electric Gamma Ray Density Sonic Neutron Other: \_\_\_\_\_  
Name of organization running log(s): \_\_\_\_\_

I certify that the well was drilled, constructed, and completed in accordance with all applicable requirements of the Mississippi Department of Environmental Quality and/or the Mississippi Department of Health regulations and state laws.

Print Name of Water Well Contractor and License No. Leeper Drilling # 0079


Signature of Water Well Contractor [Signature]

RECEIVED

DEC 07 2011

BY: OLWR

If well telescopes please sketch below and show depths.

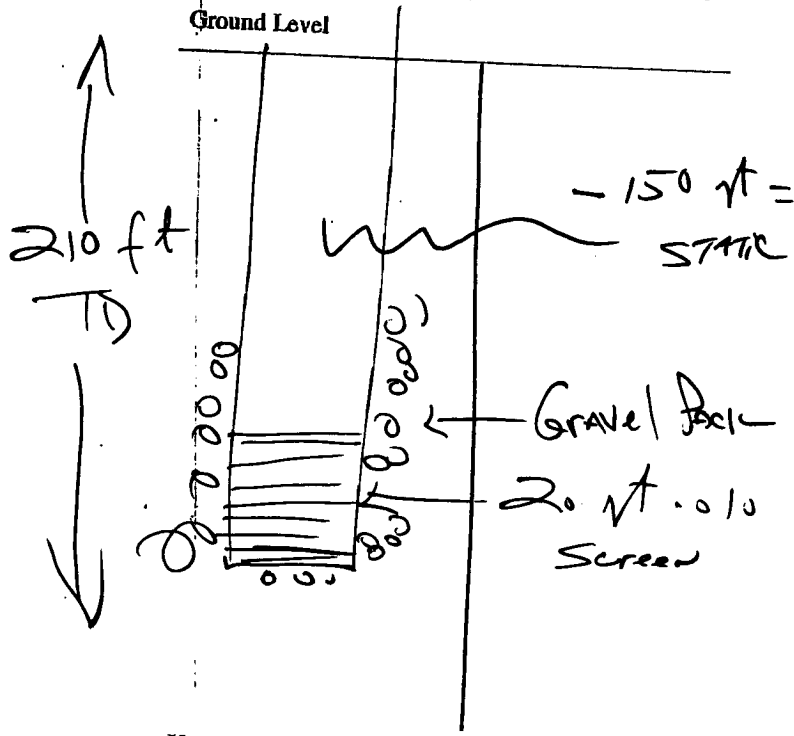

Description of Formations Encountered	From	To
Red Clay	0	30
Brown Sand	30	120
White Sand	120	210

If more than one screen, show location of each on sketch

Sketch the property layout and include the following: 1) the well location; 2) any permanent structures on the property that may aid in locating the well; 3) any roads, power lines, or other items that may aid in locating the property and the well; 4) indicate direction.

A hand-drawn property layout sketch. On the left, a rectangle is labeled 'CAMPER TRAILER'. To its right, a box with an 'X' inside is labeled 'Well' with an arrow pointing to it. A road is drawn on the right side, labeled 'CR 1069'. Below the road, there is a note: 'lat/long does not match this loc'. At the bottom, there are two dashed horizontal lines representing a road or boundary.

Landowner Name: Greg Bursavich

Signature of Water Well Contractor

RECEIVED  
DEC 9 7 2011  
BY: OLWR

# STATE WELL REPORT

## Part 2

Pump Installer's Completion Report  
Mississippi Department of Environmental Quality  
Office of Land and Water Resources  
P.O. Box 10631  
Jackson, MS 39289-0631  
(601)961-5210  
(601)354-6938 (fax)

For Office Use Only:

Aquifer: \_\_\_\_\_  
Well #: E119  
Elevation: \_\_\_\_\_

County: Lafayette  
Permit #: \_\_\_\_\_  
Driller: Zeeper Drilling  
Date completed: 11-18-11

This report should be prepared by the pump installer in detail and filed with the Department within 30 days of the installation of pump.

### Well Owner Information

Owner Name: Greg Bursavich  
Mailing Address: CR 1069  
Oxford, MS 38655  
City State Zip Code  
Telephone No. (225) 813-6210

### Well Location

Latitude: 34° 22.218 Longitude: 89° 41.674  
Method of Lat/Long (circle one): Conventional Survey,  
USGS quad, Hand-held GPS Survey-grade GPS  
1/4 \_\_\_\_\_ 1/4 Sec 26 Twn 8 S Rng 5 W  
Distance Direction Nearest Town  
11 Miles W of Oxford

### Pump Type Circle one

Air Lift Jet Submersible  
Bucket Piston Turbine  
Centrifugal Rotary Flowing Well  
Other (specify): \_\_\_\_\_  
Date Pump Installed: 11-18-11  
Rated Pump Capacity: 20 Gallons Per Minute

### Power Type Circle one

Diesel Engine Gasoline Engine Natural Gas  
Electric Motor Hand Tractor PTO  
Windmill Other (specify): \_\_\_\_\_  
Horse Power Rating of Motor: 1 1/2 HP  
Setting Depth: 180 feet  
Number of Stages: 11

### Pump Test Data

Date Well Tested: 11-18-11  
Static Water Level (A): 150 Feet Below Land Surface  
Pumping Water Level (B): \_\_\_\_\_ Feet Below Land Surface  
Drawdown [(B) - (A)]: \_\_\_\_\_ Feet Below Land Surface  
Test Pumping Rate: \_\_\_\_\_ Gallons Per Minute  
Duration of Pump Test (minimum 4 hours): \_\_\_\_\_ hours

### Method of Measuring Water Level Circle one

Air Line Electric Measuring Line Steel Tape  
Other (specify): \_\_\_\_\_  
For flowing well, measured shut in head: \_\_\_\_\_ feet  
Well yielded \_\_\_\_\_ GPM with a drawdown of  
\_\_\_\_\_ feet after \_\_\_\_\_ hours of pumping

I HEREBY CERTIFY that the above statements are true to the best of my knowledge.

Zeeper Drilling #0079  
Print Name of Pump Installer and License No. (if applicable)

[Signature]  
Signature of Pump Installer

RECEIVED

DEC 07 2011

BY: OLWR