

LAFAYETTE MISSISSIPPI BOARD OF WATER COMMISSIONERS

F ¹⁸/₄ OR
6-23-62 ^{HS}

WATER WELL DRILLERS LOG total No. 34

Date: June 23 1962, Driller: Robert E. Raliff County: Lafayette
(Name)


		Description & Color of Materials Sand, Clay, Red Clay, Shell, etc.	Thick- ness Feet	Depth Feet
(1) Owner of Land: <u>Mrs. John F Baker</u> (Name)		<u>Red top soil</u>	<u>0</u>	<u>100</u>
<u>Oxford, Mississippi</u> (Address)		<u>Fine sand</u>	<u>100</u>	<u>176</u>
(2) Location: <u>1/4</u> , <u>1/4</u> , Sec. <u>4</u> T. <u>8</u> R. <u>3</u>		<u>Coarse white sand</u>	<u>176</u>	<u>211</u>
<u>3</u> miles <u>EAST</u> , of <u>Oxford</u> (distance) (direction) (Nearest Town)				
(3) Topography: <input checked="" type="checkbox"/> (Hilly) <input type="checkbox"/> (Flat) <input type="checkbox"/> (Level)				
(4) Purpose of Well: <u>domestic</u> (Domestic Irrigation Municipal, Industrial, Other)				

Information upon completion of well:

- (1) Diameter 4 inches.
- (2) Total Depth 211 feet.
- (3) Water Level 140 feet below top of ground.
- (4) Cased to depth, Size 4"
- (5) Screen: Size 4", Length 20'
- (6) Were any formations sealed against pollution?
 yes, no.

If YES depth of formation ceased
Why _____

Drillers Remarks: well pumped
14 GPM

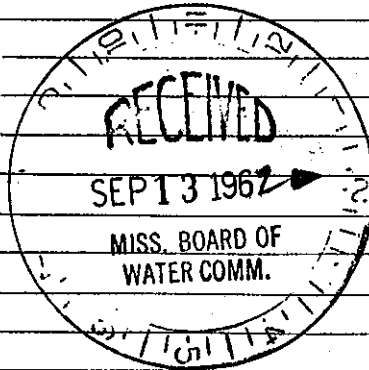

(Use Back Side)

Mail this copy to Board of Water Commissioners 429 Miss. St. Jackson, N