

Lafayette MISSISSIPPI BOARD OF WATER COMMISSIONERS

F 15
2/63 **CODED** WATER WELL DRILLERS LOG

Date: 2-25-1963, Driller: Layne-Central Co. County: _____
(Name)

| (1) Owner of Land: University of Miss. (Name) | Description & Color of Materials Sand, Clay, Red Clay, Shell, etc. | Thick- ness Feet | Depth Feet |
|---|---|------------------------|---------------|
| University, Mississippi (Address) | clay | 173' | 0-7 |
| (2) Location: SE 1/4, SW 1/4, Sec. 20, T5R12W | sandy clay st. | 7-69 | |
| _____ miles _____ of _____ (distance) (direction) (Nearest Town) | clay and sand st. | 69-109 | |
| (3) Topography: _____ (Hilly) (Flat) (Level) | sand and clay st. | 109-120 | |
| (4) Purpose of Well: Nuclear Bldg. at (Domestic Irrigation, College, Municipal, Industrial, Other) | sand-clay st. | 120-168 | |
| | clay | 168-200 | |

CODED


Information upon completion of well:

- (1) Diameter 8" inches.
- (2) Total Depth 173' feet.
- (3) Water level _____ feet below top of ground.
- (4) Cased to 137', Size 8"
- (5) Screen: Size 6", Length 31' 2"
- (6) Were any formations sealed against pollution?
 yes, _____ no.

If YES depth of formation 137'

Why _____ required

Drillers Remarks: _____

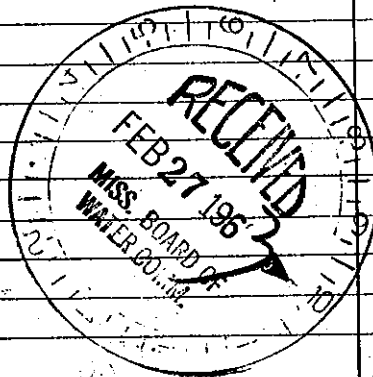

(Use Back Side)

Well No. _____