


LA FAVETTE
 F-37
 12-3-63

MISSISSIPPI BOARD OF WATER COMMISSIONERS

WATER WELL DRILLERS LOG **CODED**

Date: Dec. 3, 1963, Driller: Carlross Well Supply County _____
 (Name)

(1) Owner of Land: Univ. of Mississippi (Name)	Description & Color of Materials Sand, Clay, Red Clay, Shell, etc.	Thick- ness Feet	Depth Feet
<u>University, Mississippi</u>	Red Clay	11'	11'
<u>Golf Course</u>	Red Sand	4'	15'
(2) Location: <u>1/4, 1/4, Sec. 8 3W</u>	White Sand	8'	23'
<u>18</u>	Clay	2'	25'
<u>18</u>	Sand	79'	104'
(3) Topography: <u>18</u>	Sandy Clay	102'	106'
(Hilly) (Flat) (Level)	Coarse Sand	47'	153'
(4) Purpose of Well: <u>Irrigation</u>	Clay	74'	157'
(Domestic Irrigation, Municipal, Industrial, Other)	Rock	1'	158'
	Soft Blue Clay	89'	247'

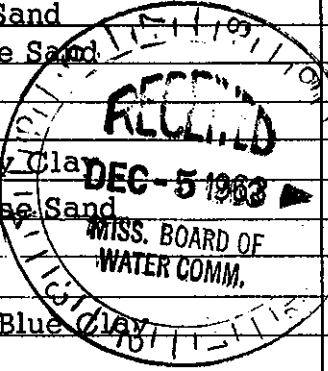

CODED

Information upon completion of well:

(1) Diameter 15 inches.

(2) Total Depth 153' feet.

(3) Water Level 70' feet below top of ground.

(4) Cased to 105', Size 10-3/4"

(5) Screen: Size 6", Length 40'

(6) Were any formations sealed against pollution?
 yes, no.

If YES depth of formation. Casing cemented

Why _____

Drillers Remarks: _____

Well No.

(Use Back Side)

Mail this copy to Board of Water Commissioners 429 Miss. St. Jackson, Miss