

LAF.

MISSISSIPPI BOARD OF WATER COMMISSIONERS

F38

4-24-61

CODED

F 308

WATER WELL DRILLERS LOG

Date: 4/24, 1961, Driller: ELLIOTT HARDWARE COMPANY
(Name) OXFORD, MISSISSIPPI County Lafayette

(1) Owner of Land: A. Q. Elliott
(Name)
Oxford, Miss
(Address)

(2) Location: 1/4, SE 1/4, Sec 19 T8536
2 miles West of Oxford
(distance) (direction) (Nearest Town)

(3) Topography: Hilly
(Hilly) (Flat) (Level)

(4) Purpose of Well: Industrial
(Domestic Irrigation
Municipal, Industrial, Other)

Description & Color of Materials Sand, Clay, Red Clay, Shell, etc.	Thick- ness Feet	Depth Feet
<u>SAND</u>	<u>30</u>	<u>30</u>
<u>Clay</u>	<u>4</u>	<u>34</u>
<u>SAND</u>	<u>157</u>	<u>191</u>
CODED		

Information upon completion of well:

(1) Diameter 4" inches.

(2) Total Depth 191 feet.

(3) Water Level 137 feet below top of ground.

(4) Cased to _____, Size _____


(5) Screen: Size 3, Length 20'

(6) Were any formations sealed against pollution?
_____ yes, _____ no.

If YES depth of formation _____

Why _____

Drillers Remarks: _____

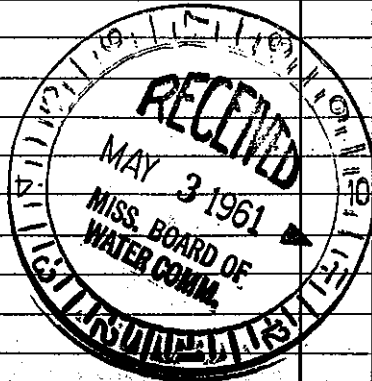

Well No.

(Use Back Side)

Mail this copy to Board of Water Commissioners 429 Miss. St. Jackson, Miss