

LAF. MISSISSIPPI BOARD OF WATER COMMISSIONERS

F 41  
10-7-63

*Coded*  
WATER WELL DRILLERS LOG

**CODED**

Date: 10/7/63, 1963, Driller: ELLIOTT HARDWARE, Oxford County, Safayette (Name, MISSISSIPPI)

(1) Owner of Land: East Oxford Water Dist  
(Name)  
Oxford, Miss  
(Address)

(2) Location: 1/4, 1/4, Sec 34 T23N  
1 miles East of Oxford  
(distance) (direction) (Nearest Town)

(3) Topography: \_\_\_\_\_  
(Hilly) (Flat) (Level)

(4) Purpose of Well: \_\_\_\_\_  
(Domestic Irrigation, Municipal, Industrial, Other)

Description & Color of Materials Sand, Clay, Red Clay, Shell, etc.	Thick- ness Feet	Depth Feet
<u>Clay, Red</u>	<u>35</u>	<u>35</u>
<u>Sand + clay</u>	<u>65</u>	<u>100</u>
<u>Sand</u>	<u>20</u>	<u>120</u>
<u>White, sticky clay</u>	<u>17</u>	<u>137</u>
<u>Black Clay</u>	<u>42</u>	<u>179</u>
<u>Sine mica sand</u>	<u>45</u>	<u>224</u>
<u>Hard Chalk rocks</u>	<u>150</u>	<u>374</u>
<u>Harder coarse clay</u>	<u>200</u>	<u>574</u>
<u>Sand</u>	<u>28</u>	<u>602</u>

Information upon completion of well:

(1) Diameter: 8 inches.

(2) Total Depth: 602 feet.

(3) Water Level: 175 feet below top of ground.

(4) Cased to: No, Size 0

(5) Screen: Size 6", Length 40'


(6) Were any formations sealed against pollution?  
\_\_\_\_\_ yes,  no.

**CODED**

If YES depth of formation \_\_\_\_\_

Why \_\_\_\_\_

Drillers Remarks: \_\_\_\_\_

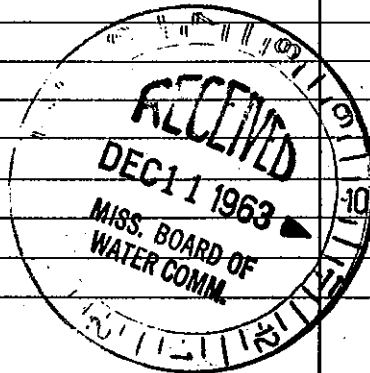

(Use Back Side)

Well No.

Mail this copy to Board of Water Commissioners 429 Miss. St. Jackson, Miss.