

MISSISSIPPI BOARD OF WATER COMMISSIONERS

LAF
~~F46~~
 8-29-64

WATER WELL DRILLERS LOG

Date: Aug 29, 1964, Driller: Elliott Hdw. Co. Laf
 (Name)

	Description & Color of Materials Sand, Clay, Red Clay, Shell, etc.	Thick- ness Feet	Depth Feet
(1) Owner of Land: <u>D.D. Childress</u> (Name) <u>Oxford, Miss.</u> (Address)	<u>clay</u>	<u>18</u>	<u>18</u>
(2) Location: <u>1/4, 1/4, Sec 22 T8R3</u> <u>7</u> miles <u>North</u> of <u>Oxford</u> (distance) (direction) (Nearest Town)	<u>sand and clay</u>	<u>218</u>	<u>236</u>
(3) Topography: <u>Hilly</u> (Hilly) (Flat) (Level)	<u>water sand</u>	<u>18</u>	<u>256</u>
(4) Purpose of Well: <u>Domestic</u> (Domestic Irrigation Municipal, Industrial, Other)	<u>Good</u>		


Information upon completion of well:

- (1) Diameter 2 inches.
- (2) Total Depth 256 feet.
- (3) Water Level 150 feet below top of ground.
- (4) Cased to _____, Size _____
- (5) Screen: Size 2, Length 5 ft.
- (6) Were any formations sealed against pollution?
 _____ yes, no.

If YES depth of formation _____

Why _____

Drillers Remarks: _____

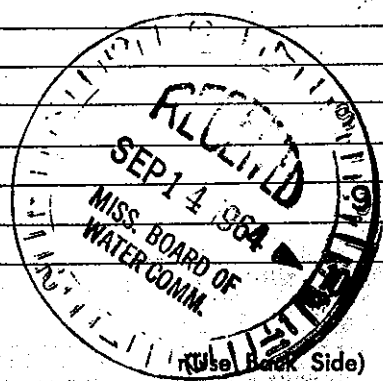

Well No. _____

Mail this copy to Board of Water Commissioners 429 Miss. St. Jackson, Miss.