

MISSISSIPPI BOARD OF WATER COMMISSIONERS

LAF.  
F50  
7-12-60


WATER WELL DRILLERS LOG

F300

Date: 7/12/, 1960, Driller: Elliott Hardware County: Lafayette

(Name)

(1) Owner of Land:	Description & Color of Materials Sand, Clay, Red Clay, Shell, etc.	Thick- ness Feet	Depth Feet
Mr. J. Lee Robbins <small>(Name)</small> RFD # 1 - Oxford, Miss. <small>(Address)</small>	Sand & rock	20'	20'
(2) Location: <u>SE 1/4 NE 1/4, Sec. 14 T. 83</u>	Sand	35'	55'
East <u>3</u> miles <u>West</u> of <u>Oxford</u> <small>(distance) (direction) (Nearest Town)</small>	Sand & clay	92'	147'
Hilly <small>(Hilly) (Flat) (Level)</small>	Water sand	15'	162'
(4) Purpose of Well: <u>Domestic</u> <small>(Domestic Irrigation Municipal, Industrial, Other)</small>	Hard Blue clay		164'
Information upon completion of well:			
(1) Diameter <u>4"</u> inches.			
(2) Total Depth <u>163'</u> feet.			
(3) Water Level <u>130'</u> feet below top of ground.			
(4) Cased to _____, Size _____			
(5) Screen: Size <u>4"</u> , Length <u>10'</u>			
(6) Were any formations sealed against pollution? _____ yes, <u>X</u> no.			
If YES depth of formation _____			
Why _____			
Drillers Remarks: _____			

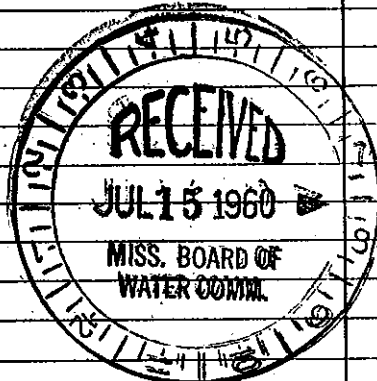

Well No. F300

(Use Back Side)

Retain this copy for your office files.