

LAF. MISSISSIPPI BOARD OF WATER COMMISSIONERS

F52

8-11-60

WATER WELL DRILLERS LOG

B309


Date: 8-11, 1960, Driller: Elliott Hardwick, County: Lafayette

(1) Owner of Land:	Description & Color of Materials Sand, Clay, Red Clay, Shell, etc.	Thick- ness Feet	Depth Feet
Legal Maps RFD 2 - Oxford, Miss. (Name) (Address)	Clay -	15	15
(2) Location: SW 1/4, Sec. 4457, T83N, R34E 4 miles North of Oxford (distance) (direction) (Nearest Town)	Sand -	16	121
(3) Topography: Hilly (Hilly) (Flat) (Level)			
(4) Purpose of Well: Domestic (Domestic Irrigation Municipal, Industrial, Other)			

Information upon completion of well:

- (1) Diameter inches.
- (2) Total Depth 121 feet.
- (3) Water Level 65 feet below top of ground.
- (4) Cased to _____, Size _____.
- (5) Screen: Size 2", Length 4'
- (6) Were any formations sealed against pollution?
_____ yes, no.

If YES depth of formation _____
Why _____
Drillers Remarks: _____

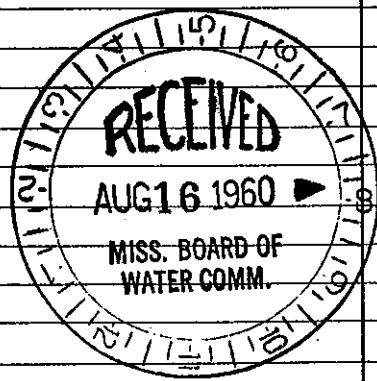

(Use Back Side)

Well No. B309