

LAF. MISSISSIPPI BOARD OF WATER COMMISSIONERS

F53

9-8-60

F302

WATER WELL DRILLERS LOG

Date: 9-8, 1960, Driller: ELLIOTT HOWE County Lafayette
(Name)

<p>(1) Owner of Land: <u>Elmore Price</u> <small>(Name)</small> <u>RFD # 2 - Oxford, Miss</u> <small>(Address)</small></p>	<p>Description & Color of Materials Sand, Clay, Red Clay, Shell, etc. <u>Hard Brown Clay</u> <u>SAND + Clay Strips</u> <u>sand -</u></p>	<p>Thick- ness Feet <u>16</u> <u>70</u> <u>40</u></p>	<p>Depth Feet <u>16</u> <u>86</u> <u>126</u></p>
<p>(2) Location: <u>NW 1/4</u>, <u>1/4</u>, Sec. <u>19</u> T<u>8R34</u> <u>2</u> miles <u>WEST</u> of <u>Oxford</u> <small>(distance) (direction) (Nearest Town)</small></p>			
<p>(3) Topography: <u>Hilly</u> <small>(Hilly) (Flat) (Level)</small></p>			
<p>(4) Purpose of Well: <u>Domestic</u> <small>(Domestic Irrigation Municipal, Industrial, Other)</small></p>			


Information upon completion of well:

- (1) Diameter inches.
- (2) Total Depth 126 feet.
- (3) Water Level 50 feet below top of ground.
- (4) Cased to _____, Size _____.
- (5) Screen: Size 1 1/4", Length 6 FT.
- (6) Were any formations sealed against pollution?
 yes, no.

If YES depth of formation _____

Why _____

Drillers Remarks: _____

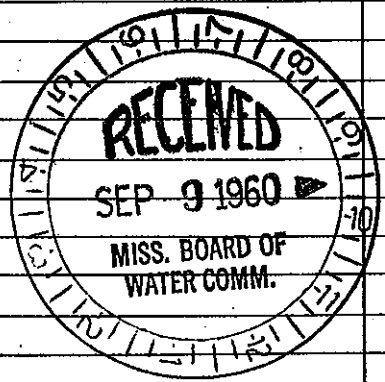

(Use Back Side)

Well No. F302

Retain this copy for your office files.