

LAF. MISSISSIPPI BOARD OF WATER COMMISSIONERS

F 54

9-26-60

F 303

WATER WELL DRILLERS LOG

Date: 9-26, 1960, Driller: Walt Hardware County: Lafayette

(Name)

(1) Owner of Land:	Description & Color of Materials Sand, Clay, Red Clay, Shell, etc.	Thick- ness Feet	Depth Feet
V. F. W. Club (Name) Oxford, Miss - Rt 1 (Address)	SAND-	224	224
(2) Location: $\frac{1}{4}$, NW $\frac{1}{4}$, Sec. 16 T8S36W 3 miles North of Oxford (distance) (direction) (Nearest Town)			
(3) Topography: Hill (Hilly) (Flat) (Level)			
(4) Purpose of Well: Domestic (Domestic Irrigation Municipal, Industrial, Other)			


Information upon completion of well:

- (1) Diameter 2 inches.
- (2) Total Depth 224 feet.
- (3) Water Level 170 feet below top of ground.
- (4) Cased to _____, Size _____
- (5) Screen: Size 2", Length 8 FT.
- (6) Were any formations sealed against pollution?
 _____ yes, _____ no.

If YES depth of formation _____

Why _____

Drillers Remarks: _____

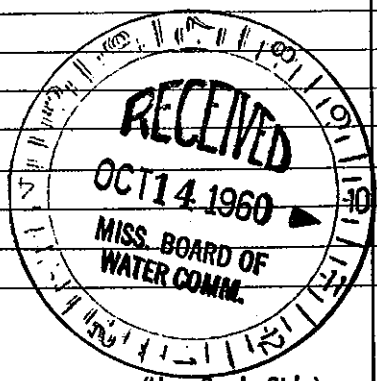

Well No. F 303

Mail this copy to Board of Water Commissioners 429 Miss. St. Jackson, Miss