

LAF. MISSISSIPPI BOARD OF WATER COMMISSIONERS

F55

1-14-61

WATER WELL DRILLERS LOG

F 304

Date: 1/14, 1961, Driller: Elliott Hardborne County: Lafayette

(Name)


(1) Owner of Land: H. H. Alderson
 (Name)
 Oxford, Miss.
 (Address)
 (2) Location: 1/4, NW 1/4, Sec 33 T8R2W
 1 miles South of Oxford
 (distance) (direction) (Nearest Town)
 (3) Topography: Hilly
 (Hilly) (Flat) (Level)
 (4) Purpose of Well: Domestic
 (Domestic Irrigation
 Municipal, Industrial, Other)

Description & Color of Materials Sand, Clay, Red Clay, Shell, etc.	Thick- ness Feet	Depth Feet
SAND & Clay	105	105
BLUE Clay	35	140
SAND & Clay	80	220
Clay	170	390
Sand	50	440
Clay	60	510
Water Sand	40	550

Information upon completion of well:

(1) Diameter: 4 inches.
 (2) Total Depth: 550 feet.
 (3) Water Level: 75 feet below top of ground.
 (4) Cased to: 105 feet, Size 4"
 (5) Screen: Size 2", Length 20'
 (6) Were any formations sealed against pollution?
 _____ yes, _____ no.

If YES depth of formation _____
 Why _____
 Drillers Remarks: _____

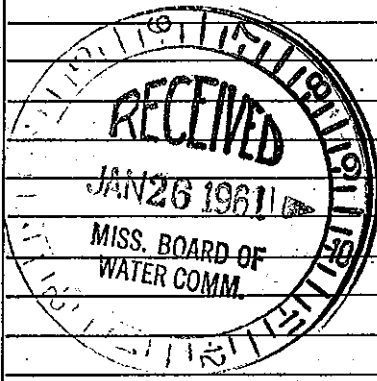

(Use Back Side)

Well No.

Retain this copy for your office files.