

LAF.
F 57
7-15-61

WATER WELL DRILLERS LOG

7 307

Date: 7/15, 1961, Driller: ELLIOTT HARDWARE CO. COUNTY Lafayette
(Name) (Name) (County) (Name) (State)

(1) Owner of Land: James E. Bennett
(Name)
Oxford, Miss. RT 1
(Address)

(2) Location: SE 1/4, 1/4 Sec. 9 T8R3
2 miles North of Oxford
(distance) (direction) (nearest town)

(3) Topography: Hilly
(Hilly) (Flat) (Level)

(4) Purpose of Well: Domestic
(Domestic Irrigation Municipal, Industrial, Other)

Description & Color of Materials Sand, Clay, Red Clay, Shell, etc.	Thick- ness Feet	Depth Feet
<u>Sand-</u>	<u>78</u>	<u>78</u>
<u>Clay-</u>	<u>7</u>	<u>85</u>
<u>Sand + Clay</u>	<u>60</u>	<u>145</u>
<u>Clay</u>	<u>6</u>	<u>151</u>
<u>Sand</u>	<u>44</u>	<u>195</u>

Information upon completion of well:

(1) Diameter 2" inches.

(2) Total Depth 195' feet.

(3) Water Level 165' feet below top of ground.

(4) Cased to no, Size ✓


(5) Screen: Size 2", Length 6'

(6) Were any formations sealed against pollution?
_____ yes, _____ no.

If YES depth of formation _____

Why _____

Drillers Remarks: _____

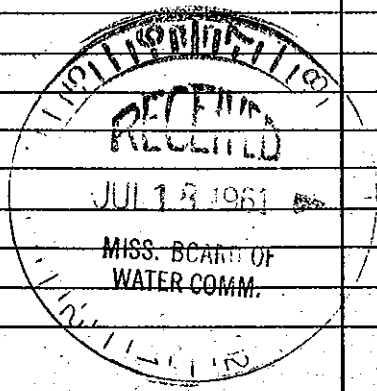

(Use Back Side)

Well No.

Retain this copy for your office files.