

LAF
F58
8-1-61
Date: 8/1

MISSISSIPPI BOARD OF WATER COMMISSIONERS

45
Lafayette

WATER WELL DRILLERS LOG


Driller: ELLIOTT HARDWARE COMPANY
Name: OXFORD, MISSISSIPPI
County: Lafayette

(1) Owner of Land: Mrs A H Arent
(Name)
Oxford, Miss
(Address)
(2) Location: 1/4, 1/4, Sec 13
3 miles N W, of Oxford
(distance) (direction) (Nearest Town)
(3) Topography: Hillis
(Hilly) (Flat) (Level)
(4) Purpose of Well: Domestic
(Domestic Irrigation
Municipal, Industrial, Other)

Description & Color of Materials Sand, Clay, Red Clay, Shell, etc.	Thick- ness Feet	Depth Feet
All Sand	97	97
PINK Clay	1	98

Information upon completion of well:

(1) Diameter 4 inches.
(2) Total Depth 98 feet.
(3) Water Level 18 feet below top of ground.
(4) Cased to , Size _____
(5) Screen: Size 3", Length 20'
(6) Were any formations sealed against pollution?
_____ yes, _____ no.
If YES depth of formation _____
Why _____
Drillers Remarks: _____

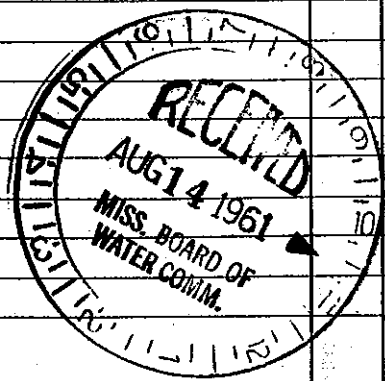

Well No.

(Use Back Side)

Mail this copy to Board of Water Commissioners 429 Miss. St. Jackson, Miss.