

LAF. MISSISSIPPI BOARD OF WATER COMMISSIONERS

F 59

8-10-61

WATER WELL DRILLERS LOG

7

Date: 8-10, 1961, Driller: ELLIOTT HARDWARE COMPANY  
 OXFORD, MISSISSIPPI County Lafayette  
 (Name)

(1) Owner of Land: Harvey Kulliard  
 (Name)  
 Oxford, Miss RT. 2  
 (Address)  
 (2) Location: 1/4, 1/4, Sec 30 T 8 S R 12 W  
 1 miles West of Oxford  
 (distance) (direction) (Nearest Town)  
 (3) Topography: Hilly  
 (Hilly) (Flat) (Level)  
 (4) Purpose of Well: Domestic  
 (Domestic Irrigation, Municipal, Industrial, Other)

Description & Color of Materials Sand, Clay, Red Clay, Shell, etc.	Thick- ness Feet	Depth Feet
Clay-	22	22
Sand-	25	47
Sand + Clay	58	105
Sand	52	157
Clay	1	158


Information upon completion of well:

(1) Diameter 2 inches.  
 (2) Total Depth 158 feet.  
 (3) Water Level 120 feet below top of ground.  
 (4) Cased to \_\_\_\_\_, Size \_\_\_\_\_  
 (5) Screen: Size 2", Length 10'  
 (6) Were any formations sealed against pollution?  
 \_\_\_\_\_ yes, \_\_\_\_\_ no.

If YES depth of formation \_\_\_\_\_

Why \_\_\_\_\_

Drillers Remarks: \_\_\_\_\_

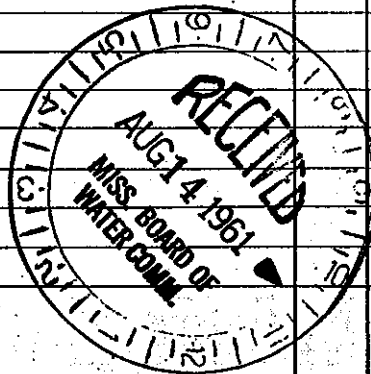

(Use Back Side)

Well No.

Retain this copy for your office files.