

F 60
9-18-61

WATER WELL DRILLERS LOG


Date: 9-18, 1961, Driller: Elliott Howe Co. County: Lafayette

(1) Owner of Land:	Description & Color of Materials Sand, Clay, Red Clay, Shell, etc.	Thick- ness Feet	Depth Feet
Mas Lewis Jr (Name) Oxford Miss Pl 3 (Address)	Clay	32	32
Location: 1/4 SW 1/4, Sec 27 T8 R1W 1/4 miles East of Oxford (distance) (direction) (Nearest Town)	Brown Sand-	33	65
Topography: Hilly (Hilly) (Flat) (Level)	White Sand-	43	108
Purpose of Well: Domestic (Domestic Irrigation Municipal, Industrial, Other)	Pink Clay	1	109

Information upon completion of well:

- (1) Diameter inches.
- (2) Total Depth 109 feet.
- (3) Water Level 40 feet below top of ground.
- (4) Cased to NO, Size ~~2" x 5'~~
- (5) Screen: Size 2", Length 5'
- (6) Were any formations sealed against pollution?
_____ yes, _____ no.

If YES depth of formation _____
Why _____
Drillers Remarks: _____

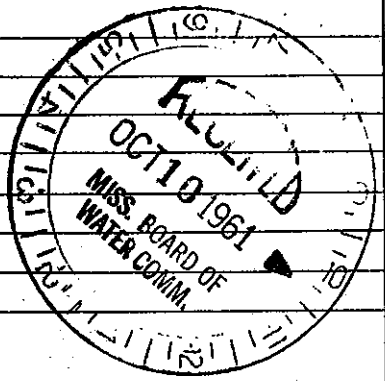

(Use Back Side)

Well No.