

LAF

MISSISSIPPI BOARD OF WATER COMMISSIONERS

F 61

7

10-5-61

WATER WELL DRILLERS LOG

Date: 10-5, 1961, Driller: Elliott Hardware County Lafayette

(1) Owner of Land: GENE Ragland
(Name)
Oxford, Miss - PT 2
(Address)

(2) Location: 1/4, SW 1/4, Sec 20 T 85 R 34
1 1/2 miles WEST, of Oxford
(distance) (direction) (Nearest Town)

(3) Topography: Hilly
(Hilly) (Flat) (Level)

(4) Purpose of Well: Domestic
(Domestic Irrigation Municipal, Industrial, Other)

Description & Color of Materials Sand, Clay, Red Clay, Shell, etc.	Thick- ness Feet	Depth Feet
<u>Red Clay</u>	<u>10</u>	<u>10</u>
<u>SAND & Clay</u>	<u>140</u>	<u>150</u>
<u>Big Coarse Sand</u>	<u>19</u>	<u>169</u>

Information upon completion of well:

(1) Diameter 2 inches.

(2) Total Depth 169' feet.

(3) Water Level 75 feet below top of ground.

(4) Cased to No, Size _____


(5) Screen: Size 2", Length 8'

(6) Were any formations sealed against pollution?
 _____ yes, ✓ no.

If YES depth of formation _____

Why _____

Drillers Remarks: _____

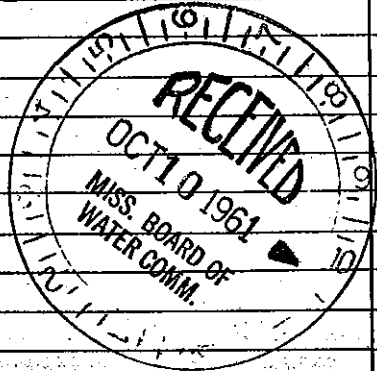

Well No.

(Use Back Side)

Retain this copy for your office files.