

LAF. MISSISSIPPI BOARD OF WATER COMMISSIONERS

F62
2-10-62

WATER WELL DRILLERS LOG


Date: 2/10, 1962, Driller: Elliott Reed County: Lafayette
(Name)

(1) Owner of Land:	Description & Color of Materials Sand, Clay, Red Clay, Shell, etc.	Thick- ness Feet	Depth Feet
<u>B. D. Martin</u> (Name)	Clay	30	30
<u>Oxford Miss</u> (Address)	Sand	40	70
(2) Location: <u>1/4, SE 1/4, Sec 30 T 9 R 3</u>	Clay	2	72
<u>2</u> miles <u>East</u> of <u>Oxford</u>	Sand - Brown	60	132
(distance) (direction) (Nearest Town)	Clay	4	136
(3) Topography: <u>Hilly</u>	SAND	24	160
(Hilly) (Flat) (Level)			
(4) Purpose of Well: <u>Domestic</u>			
(Domestic Irrigation Municipal, Industrial, Other)			

Information upon completion of well:

- (1) Diameter 3 inches.
- (2) Total Depth 160 feet.
- (3) Water Level 120 feet below top of ground.
- (4) Cased to _____, Size _____
- (5) Screen: Size 2', Length 5'
- (6) Were any formations sealed against pollution?
_____ yes, no.

If YES depth of formation _____
Why _____
Drillers Remarks: _____

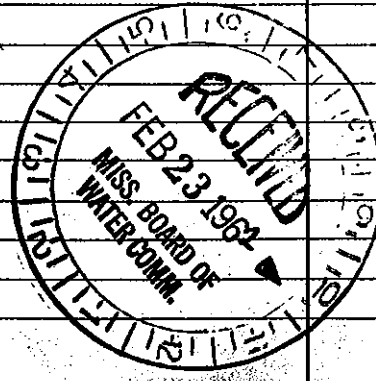

(Use Back Side)

Well No.

Retain this copy for your office files.