

L.A.F. MISSISSIPPI BOARD OF WATER COMMISSIONERS

F63

2-19-62

WATER WELL DRILLERS LOG

Date: 2/19, 1962, Driller: Elliott H. Hideo County: Lafayette
 (Name)


(1) Owner of Land: Tom Mastless
 (Name)
Okford, Miss-
 (Address)
 (2) Location: 1/4 SE 1/4, Sec. 18 T18R31W
2 miles West of Okford
 (distance) (direction) (Nearest Town)
 (3) Topography: Hilly
 (Hilly) (Flat) (Level)
 (4) Purpose of Well: Domestic
 (Domestic Irrigation, Municipal, Industrial, Other)

Description & Color of Materials Sand, Clay, Red Clay, Shell, etc.	Thick- ness Feet	Depth Feet
Top Red Clay	10	10
Sand + clay	65	75
Sand-	5	80
Pink clay	1	81
Water Sand	19	100
Pink clay	1	101

Information upon completion of well:

(1) Diameter 4 inches.
 (2) Total Depth 101 feet.
 (3) Water Level 42 feet below top of ground.
 (4) Cased to _____, Size _____
 (5) Screen: Size 3", Length 10'
 (6) Were any formations sealed against pollution?
 _____ yes, no.

If YES depth of formation _____
 Why _____
 Drillers Remarks: _____

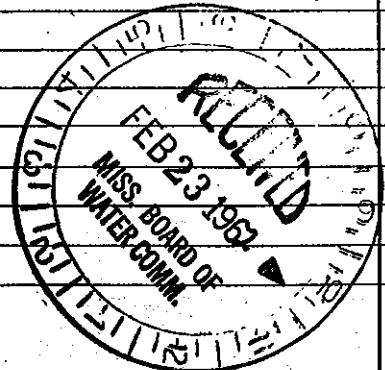

(Use Back Side)

Well No.

Retain this copy for your office files.