

MISSISSIPPI BOARD OF WATER COMMISSIONERS

L.A.F.
F64
3-8-62

WATER WELL DRILLERS LOG


Date: 3/8, 1962, Driller: ELLIOTT HARDWARE COMPANY County LaSayette
(Name)

(1) Owner of Land <small>(Name)</small>	Description & Color of Materials Sand, Clay, Red Clay, Shell, etc.	Thick- ness Feet	Depth Feet
<u>Mr James Hudson</u> <small>(Address)</small>	<u>SAND "Red"</u>	<u>42</u>	<u>42</u>
<u>Oxford, Miss. RT 4</u> <small>(Address)</small>	<u>Clay "Red"</u>	<u>21</u>	<u>63</u>
(2) Location: <u>1/4, NE 1/4, Sec 27, T8S, R34E</u>	<u>SAND + Clay</u>	<u>22</u>	<u>85</u>
<u>2</u> miles <u>East</u> of <u>Oxford</u>	<u>SAND - "S"</u>	<u>14</u>	<u>99</u>
<small>(distance) (direction) (Nearest Town)</small>	<u>Clay - Pink</u>	<u>2</u>	<u>101</u>
(3) Topography: <u>Hilly</u>	<u>Clay - White</u>	<u>1</u>	<u>102</u>
<small>(Hilly) (Flat) (Level)</small>			
(4) Purpose of Well: <u>Domestic</u> <small>(Domestic Irrigation Municipal, Industrial, Other)</small>			

Information upon completion of well:

- (1) Diameter 2 inches.
- (2) Total Depth 102 feet.
- (3) Water Level 60' feet below top of ground.
- (4) Cased to 0, Size 0.
- (5) Screen: Size 2", Length 5'.
- (6) Were any formations sealed against pollution?
 yes, no.

If YES depth of formation _____
 Why _____
 Drillers Remarks: _____

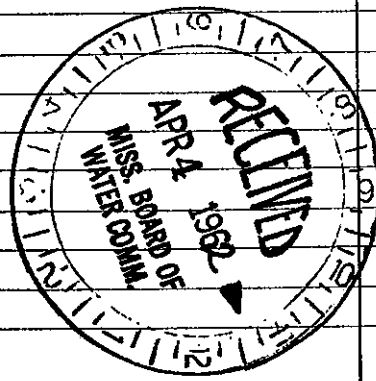

(Use Back Side)

Well No.

Mail this copy to Board of Water Commissioners 429 Miss. St. Jackson, Miss