

MISSISSIPPI BOARD OF WATER COMMISSIONERS

LAF.  
F65  
3-17-62

WATER WELL DRILLERS LOG

ELLIOTT HARDWARE COMPANY


Date: 3/17, 1962, Driller: OXFORD, MISSISSIPPI County Lafayette  
(Name)

(1) Owner of Land	Description & Color of Materials Sand, Clay, Red Clay, Shell, etc.	Thick- ness Feet	Depth Feet
<u>Elizabeth Rogers</u> (Name) <u>Oxford, Miss</u> (Address)	Top Clay	10	10
	Sand + clay	50	60
	Clay	5	65
(2) Location: <u>1/4</u> , <u>1/4</u> , Sec. <u>27 T. 8 R. 3</u>	Sand + clay	15	80
<u>1</u> miles <u>East</u> , of <u>Oxford</u> (distance) (direction) (Nearest Town)	Water sand	4	84
	yellow clay	2	87
(3) Topography: <u>Hilly</u> (Hilly) (Flat) (Level)	Sand + clay	39	126
	Sand	15	141
(4) Purpose of Well: <u>Domestic</u> (Domestic Irrigation Municipal, Industrial, Other)			

Information upon completion of well:

- (1) Diameter 2<sup>1</sup> inches.
- (2) Total Depth 141 feet.
- (3) Water Level 70 feet below top of ground.
- (4) Cased to , Size
- (5) Screen: Size 2<sup>1</sup>, Length 5'
- (6) Were any formations sealed against pollution?  
 yes,  no.

If YES depth of formation \_\_\_\_\_  
Why \_\_\_\_\_  
Drillers Remarks: \_\_\_\_\_

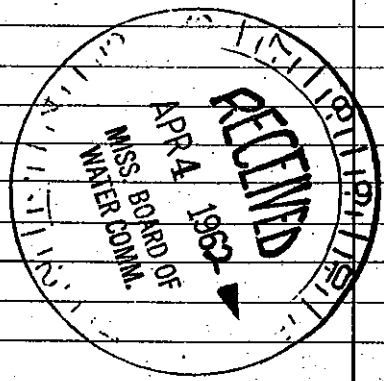

Well No. \_\_\_\_\_

(Use Back Side)

Retain this copy for your office files.