

L.A.F. MISSISSIPPI BOARD OF WATER COMMISSIONERS

F68  
7-21-62

WATER WELL DRILLERS LOG

Date: 7-21, 1962, Driller: Elliott Handwire Lafayette  
(Name)

(1) Owner of Land: Walker Lee  
(Name)  
Oxford, Miss  
(Address)

(2) Location: 1/4, 1/4, Sec 15 T 8R R3W  
2 miles East of Oxford  
(distance) (direction) (Nearest Town)

(3) Topography: Hilly  
(Hilly) (Flat) (Level)

(4) Purpose of Well: Domestic  
(Domestic Irrigation  
Municipal, Industrial, Other)

Description & Color of Materials Sand, Clay, Red Clay, Shell, etc.	Thick- ness Feet	Depth Feet
Clay & Rocks	0	23
Sand & Clay	61	84
Clay - white	5	89
Strip of Sand & Clay	58	147
Sand	47	194


Information upon completion of well:

- (1) Diameter 4 inches.
- (2) Total Depth 194 feet.
- (3) Water Level 120 feet below top of ground.
- (4) Cased to no, Size \_\_\_\_\_.
- (5) Screen: Size 4", Length 10'.
- (6) Were any formations sealed against pollution?  
\_\_\_\_\_ yes, \_\_\_\_\_ no.

If YES depth of formation \_\_\_\_\_

Why \_\_\_\_\_

Drillers Remarks: \_\_\_\_\_

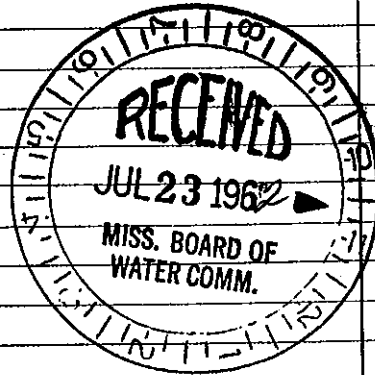

Well No. \_\_\_\_\_

(Use Back Side)

Mail this copy to Board of Water Commissioners 429 Miss. St. Jackson, Miss.