

F 72  
12-7-62

WATER WELL DRILLERS LOG

Date: 12-7, 1962, Driller: ELLIOTT HARDWARE COMPANY *Lafayette*  
(Name) OXFORD, MISSISSIPPI County

| (1) Owner of Land:  | Description & Color of Materials<br>Sand, Clay, Red Clay, Shell, etc. | Thick-<br>ness<br>Feet | Depth<br>Feet |
|---|---|------------------------|---------------|
| <u>Stallen Key</u><br>(Name)<br><u>Oxford, Miss</u><br>(Address)                              | <u>Red Clay -</u>   | <u>15</u>              | <u>15</u>     |
| (2) Location: <u>1/4, 1/4, Sec. 14 T8S R31W</u>   | <u>Sand + clay +</u>  | <u>80</u>              | <u>95</u>     |
| <u>2</u> miles <u>East</u> of <u>Oxford</u><br>(distance) (direction) (Nearest Town)          | <u>Clay waste</u>   | <u>10</u>              | <u>105</u>    |
| (3) Topography: <u>Hilly</u><br>(Hilly) (Flat) (Level)  | <u>Sand + Clay -</u>  | <u>35</u>              | <u>140</u>    |
| (4) Purpose of Well: <u>Domestic</u><br>(Domestic Irrigation<br>Municipal, Industrial, Other) | <u>Clay - Pink -</u>  | <u>2</u>               | <u>142</u>    |
|   | <u>Sand -</u>   | <u>18</u>              | <u>160</u>    |
|   | <u>Hard Blue Clay</u>   | <u>1</u>               | <u>161</u>    |


Information upon completion of well:

- (1) Diameter 2 inches.
- (2) Total Depth 160 feet.
- (3) Water Level 120 feet below top of ground.
- (4) Cased to No, Size ✓
- (5) Screen: Size 2", Length 6'
- (6) Were any formations sealed against pollution?  
no

If YES depth of formation \_\_\_\_\_

Why \_\_\_\_\_

Drillers Remarks: \_\_\_\_\_

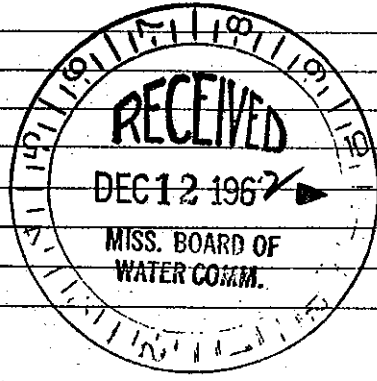

(Use Back Side)

Well No.