

LAF. MISSISSIPPI BOARD OF WATER COMMISSIONERS

F 73
2-7-63

WATER WELL DRILLERS LOG

Date 2-7, 1963, Driller: Elliott H. Adde County W. Lafayette
(Name)

(1) Owner of Land:	Description & Color of Materials Sand, Clay, Red Clay, Shell, etc.	Thick- ness Feet	Depth Feet
<u>Mrs. C. N. Paine</u> (Name) <u>RFD # 1 Oxford, Miss</u> (Address)	<u>Red Clay</u>	<u>15'</u>	<u>15'</u>
(2) Location: <u>1/4</u> , <u>1/4</u> , Sec. <u>10 T8S R3W</u>	<u>Red Sand & Clay</u>	<u>11'</u>	<u>132'</u>
<u>3</u> miles <u>N. E.</u> of <u>Oxford</u> (distance) (direction) (Nearest Town)	<u>White Clay</u>	<u>11'</u>	<u>143'</u>
(3) Topography: <u>Hilly</u> (Hilly) (Flat) (Level)	<u>White Sand</u>	<u>24'</u>	<u>167'</u>
(4) Purpose of Well: <u>DOMESTIC</u> (Domestic Irrigation Municipal, Industrial, Other)	<u>Pink Pipe Clay</u>	<u>3"</u>	


Information upon completion of well:

- (1) Diameter 2 inches.
- (2) Total Depth 167 feet.
- (3) Water Level 120 feet below top of ground.
- (4) Cased to No, Size No.
- (5) Screen: Size 2", Length 6'.
- (6) Were any formations sealed against pollution?
_____ yes, X no.

If YES depth of formation _____

Why _____

Drillers Remarks: _____

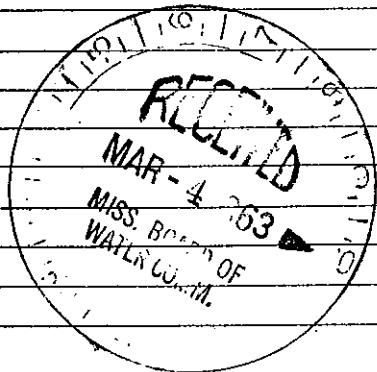

(Use Back Side)

Well No.