

LAF. MISSISSIPPI BOARD OF WATER COMMISSIONERS

F 74

4-24-63

WATER WELL DRILLERS LOG

Date: April 14 1963, Driller: ELLIOTT HARDWARE COMPANY, OXFORD, MISSISSIPPI County Lafayette
(Name)

(1) Owner of Land: Thomas Paton
(Name)
Oxford, Miss
(Address)

(2) Location: 24 S 36
4 miles East of Oxford
(distance) (direction) (Nearest Town)

(3) Topography: Hilly
(Hilly) (Flat) (Level)

(4) Purpose of Well: Domestic
(Domestic Irrigation) (Municipal, Industrial, Other)

Description & Color of Materials Sand, Clay, Red Clay, Shell, etc.	Thick- ness Feet	Depth Feet
Clay - Red	32	32
Sand & Clay	15	47
Sand	20	67

Information upon completion of well:

(1) Diameter 4 inches.

(2) Total Depth 167 feet.

(3) Water Level 147 feet below top of ground.

(4) Cased to No, Size 0


(5) Screen: Size 4", Length 8'

(6) Were any formations sealed against pollution?
 _____ yes, no.

If YES depth of formation _____

Why _____

Drillers Remarks: _____

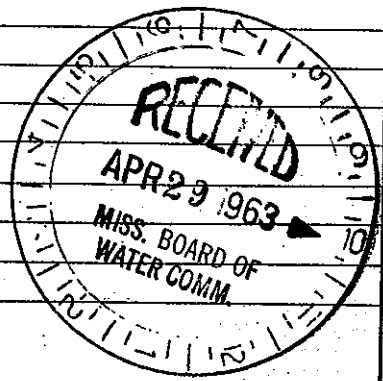

(Use Back Side)

Well No.