

LAF. MISSISSIPPI BOARD OF WATER COMMISSIONERS

F75
4-25-63

WATER WELL DRILLERS LOG

ELLIOTT HARDWARE COMPANY

Date: 4-25, 1963, Driller: OXFORD, MISSISSIPPI County Lafayette

(1) Owner of Land (Name)	Description & Color of Materials Sand, Clay, Red Clay, Shell, etc.	Thick- ness Feet	Depth Feet
TENN Pulp Wood (Address)	Red Clay	19	19
(2) Location: 1/4 NW 1/4, Sec. 4 T8S R36E	Sand	171	190
3 miles North of Oxford (distance) (direction) (Nearest Town)			
(3) Topography: Hilly (Hilly) (Flat) (Level)			
(4) Purpose of Well: Domestic (Domestic Irrigation Municipal, Industrial, Other)			


Information upon completion of well:

- (1) Diameter 4 inches.
- (2) Total Depth 190 feet.
- (3) Water Level 162 feet below top of ground.
- (4) Cased to No, Size 0
- (5) Screen: Size 3, Length 10'
- (6) Were any formations sealed against pollution?
yes, no.

If YES depth of formation _____

Why _____

Drillers Remarks: _____

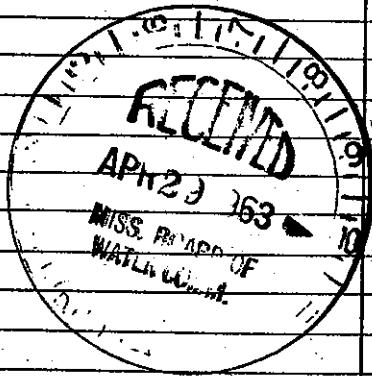

Well No.

(Use Back Side)

Retain this copy for your office files.