

LAF.
 F76
 6-18-63

MISSISSIPPI BOARD OF WATER COMMISSIONERS

WATER WELL DRILLERS LOG

Date: JUNE 13 1963, Driller: EMORY HOWE County Calhoun

(Name)

(1) Owner of Land: A. Q. Smith
(Name)
RFD #1 Oxford Miss
(Address)

(2) Location: $\frac{1}{4}$, $\frac{1}{4}$, Sec. 13 T8 R3
6 miles East of Oxford
(distance) (direction) (Nearest Town)

(3) Topography: Hilly
(Hilly) (Flat) (Level)

(4) Purpose of Well: Domestic
(Domestic Irrigation
 Municipal, Industrial, Other)

Description & Color of Materials Sand, Clay, Red Clay, Shell, etc.	Thick- ness Feet	Depth Feet
<u>Red Clay</u>	<u>22</u>	<u>22</u>
<u>Sand & clay</u>	<u>63</u>	<u>85</u>
<u>SAND</u>	<u>10</u>	<u>95</u>
<u>Clay</u>	<u>5</u>	<u>100</u>
<u>Sand & Clay</u>	<u>35</u>	<u>135</u>
<u>Sand</u>	<u>34</u>	<u>169</u>

Information upon completion of well:

(1) Diameter 4 inches.

(2) Total Depth 169 feet.

(3) Water Level 90 feet below top of ground.

(4) Cased to No., Size NO


(5) Screen: Size 2", Length 10'

(6) Were any formations sealed against pollution?
 _____ yes, no.

If YES depth of formation _____

Why _____

Drillers Remarks: _____

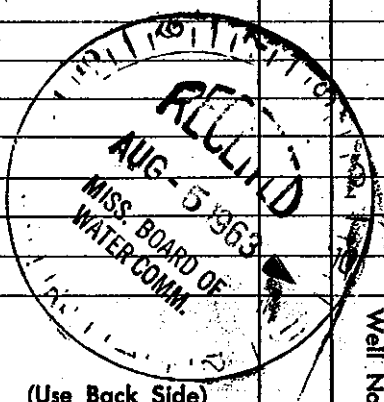

Well No.

(Use Back Side)

Retain this copy for your office files.