

LAF. MISSISSIPPI BOARD OF WATER COMMISSIONERS

F 78

7-13-63

WATER WELL DRILLERS LOG

Date: 7-13, 1963, Driller: Elliott H. Hume County: Lafayette

(Name)

(1) Owner of Land:	Description & Color of Materials Sand, Clay, Red Clay, Shell, etc.	Thick- ness Feet	Depth Feet
<u>HOME Products Inc</u> (Name)	<u>Clay</u>	<u>25</u>	<u>25</u>
<u>Oxford, Miss</u> (Address)	<u>Sandy clay</u>		
<u>IN City of Oxford</u> (Address)			
(2) Location: <u>1/4</u> Sec. <u>28</u> T. <u>8</u> R. <u>3</u>			
<u>0</u> miles <u>0</u> of <u>0</u> (distance) (direction) (Nearest Town)			
(3) Topography: _____ (Hilly) (Flat) (Level)			
(4) Purpose of Well: <u>Commercial</u> (Domestic Irrigation Municipal, Industrial, Other)			


Information upon completion of well:

- (1) Diameter 6 inches.
- (2) Total Depth 140 feet.
- (3) Water Level 120 feet below top of ground.
- (4) Cased to no, Size no
- (5) Screen: Size 4", Length 20'
- (6) Were any formations sealed against pollution?  
\_\_\_\_\_ yes, X no.

If YES depth of formation \_\_\_\_\_

Why \_\_\_\_\_

Drillers Remarks: \_\_\_\_\_

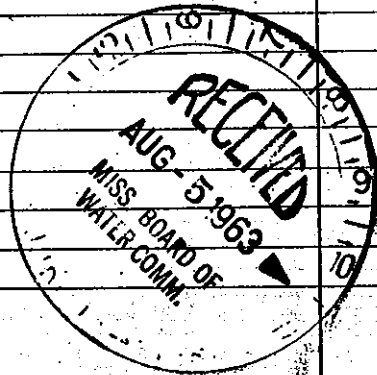

(Use Back Side)

Well No.

Retain this copy for your office files.