

MISSISSIPPI BOARD OF WATER COMMISSIONERS

WATER WELL DRILLERS LOG

F 79
 12-6-63
 Date: 12/6/63, Driller: Elliott Howe County Lafayette

(1) Owner of Land: V.H. Hall (Name)
 Oxford, Miss. (Address)

(2) Location: 1/4, Sec 2, T 836
 2 miles West of Oxford (distance, direction, Nearest Town)

(3) Topography: Hill (Hilly, Flat, Level)


(4) Purpose of Well: Domestic (Domestic Irrigation, Municipal, Industrial, Other)

Description & Color of Materials Sand, Clay, Red Clay, Shell, etc.	Thick- ness Feet	Depth Feet
Red Clay	27	27
Sand	130	157
Clay-Sand	10	167
Sand	45	212

Information upon completion of well:

- (1) Diameter 4 inches.
- (2) Total Depth 212 feet.
- (3) Water Level 140 feet below top of ground.
- (4) Cased to No, Size —
- (5) Screen: Size 2 1/2, Length 10'
- (6) Were any formations sealed against pollution?
 yes, no.

If YES depth of formation _____
 Why _____
 Drillers Remarks: _____

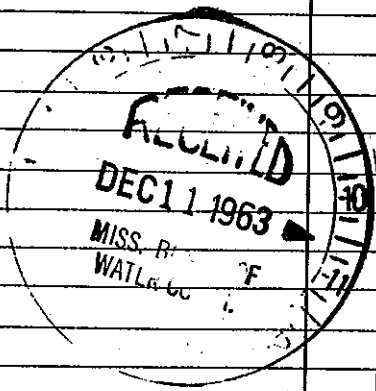

Well No.

(Use Back Side)

Mail this copy to Board of Water Commissioners 429 Miss. St. Jackson, Miss.