

LAF. MISSISSIPPI BOARD OF WATER COMMISSIONERS

F81

10-28-64

WATER WELL DRILLERS LOG

Date: 10-28, 1964, Driller: Elliott H. White County Popoyatta  
(Name)

(1) Owner of Land	Description & Color of Materials Sand, Clay, Red Clay, Shell, etc.	Thick- ness Feet	Depth Feet
John Holcomb (Name)	Red Clay -	63	63
Oxford, Miss - (Address)	Sand + Clay	80	143
(2) Location: 1/4, 1/4, Sec. 27 T. 33N	Sand	19	162
1 1/2 miles East, of Oxford (distance) (direction) (Nearest Town)			
(3) Topography: Hill (Hilly) (Flat) (Level)			
(4) Purpose of Well: Domestic Irrigation (Domestic Irrigation Municipal, Industrial, Other)			


Information upon completion of well:

- (1) Diameter 2" inches.
- (2) Total Depth 162 feet.
- (3) Water level 120 feet below top of ground.
- (4) Cased to No, Size \_\_\_\_\_
- (5) Screen: Size 2", Length 6'
- (6) Were any formations sealed against pollution?  
\_\_\_\_\_ yes,  no.

If YES depth of formation \_\_\_\_\_

Why \_\_\_\_\_

Drillers Remarks: \_\_\_\_\_

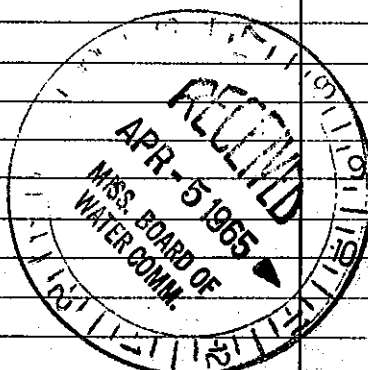

Well No.

(Use Back Side)

Mail this copy to Board of Water Commissioners 429 Miss. St. Jackson, Miss