

MISSISSIPPI
BOARD OF WATER COMMISSIONERS
416 North State Street
Jackson, Mississippi 39201

WATER WELL DRILLERS LOG

Lafayette
783
11-67


Nov 22 1967 date well completed
Johnson & Son firm name
Lafayette county well located

LANDOWNER	description of formations encountered	from	to
Ben Suchman			
OK	Red sand + clay	0	20
Oxford, Miss	Orange clay	20	60
(mailing address)	White sand	60	80

WELL LOCATION:
sec. 18 T. 8 N R. 3 E
3 1/2 miles NW of Oxford
(distance) (direction) (nearest town)

WELL PURPOSE: domestic
(home, irrigation, municipal, industrial)

- WELL COMPLETION DATA:
- (1) diameter (inches) 4
 - (2) total depth (feet) 80
 - (3) static water level (feet) 50 below top of ground.
 - (4) casing plastic, 75 (material) (depth)
1/2" if telescope see back. (size)
 - (5) screen 5 ft, 75 (length) (depth to top)
1/2" gravel packed (size) (material)
 - (6) pump 1/2 (HP) 24 (yield gpm)
1/2 HP (type power)
 - (7) electric log no (yes or no)
(organization running log)
 - (8) how well bottom plugged plugged

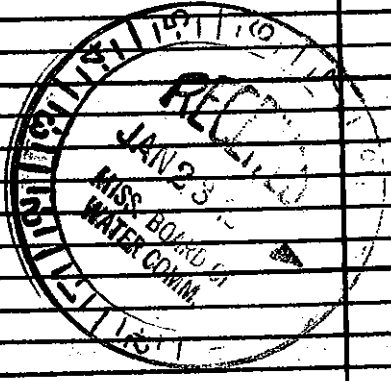

DRILLERS REMARKS: plastic water well