

Lafayette
784
1-68

MISSISSIPPI
BOARD OF WATER COMMISSIONERS
416 North State Street
Jackson, Mississippi 39201

WATER WELL DRILLERS LOG

1-18-68 19 LAMAR WILGER LAFAYETTE
date well completed firm name county well located


LANDOWNER:
L. G. BLYNCH
OXFORD, MISS
(mailing address)

| description of formations encountered | from | to |
|---------------------------------------|------|-----|
| Red SAND | 0 | 80 |
| BROWNISH SAND | 80 | 100 |
| WHITESAND | 100 | 136 |

WELL LOCATION:
sec. 14 T 8 S R 3 W
3 miles NE of OXFORD
(distance) (direction) (nearest town)

WELL PURPOSE: HOME
(home, irrigation, municipal, industrial)

- WELL COMPLETION DATA:
- (1) diameter (inches) 4"
 - (2) total depth (feet) 136
 - (3) static water level (feet) 70 below above top of ground.
 - (4) casing STEEL 126
(material) (depth)
4" (size) if telescope see back.
 - (5) screen 10' 126
(length) (depth to top)
4" STAINLESS
(size) (material)
 - (6) pump 1 12
(HP) (yield gpm)
ELECTRIC
(type power)
 - (7) electric log NO
(yes or no)
(organization running log)
 - (8) how well bottom plugged

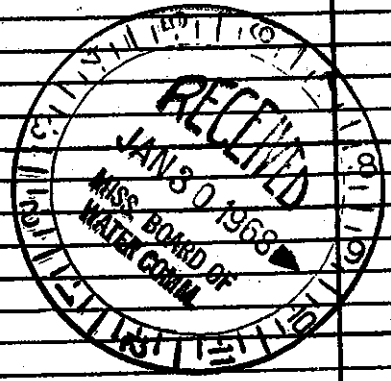

DRILLERS REMARKS: