
	State Well Report
County: LALAYETTE	Part 1 For Office Use Only
Permit #:	ippi Department of Environmental Quality Aquifer:
	Office of Land and Water Resources
Driller: Leeper Drilling	
Date drilling completed: 4-15-04	Jackson, MS 39289-0631 (601)961-5210
	(601)354-6938 (fax) E-log #:
State Law requires that this report he are	
	epared by the driller in detail and filed with the Department with
Well Owner Information	XX7 19 #
Owner Name Rober 7 Lampto	
Mailing Address:	Latitude:' Longitude:'
wanter voncess:	Method of Lat/Long (circle one): Conventional Survey,
Marken Mc	USGS quad, Hand-held GPS, Survey-grade GPS
City ACKSON MS	Zip Code 4 14 Sec 18 Twn 8 5 Rng 3
Telephone No. (001) 933 - 3325	Distance Direction Nearest Tour
	Distance Direction Nearest Town <u>12</u> Miles <u>4</u> of <u>0×4</u>
	Well Data
Purpose of Well (circle one) Home Industrial P	
	Public Supply Irrigation Fish Culture Other:
Date well drilling started:	Date well drilling completed: 4-19- 56
If flowing, method of flow regulation, Value	
If flowing, method of flow regulation: Valve	Other (describe)
Static Water Level:feet above or below	(circle one) land surface Date measured: 4-20-06
Method of Measurement (circle one) steel tape	alastria (
	electric tape air line other:
	2544 Well grouted to a depth offeet
Type of grout (circle one): Cement Bentonite	e Mix
<i>.</i>	
8	<u>4'</u> inches Type of casing: <u>PUC</u>
Screen length:feet Screen diameter:	
	idences Type of screen:
	lepth: Fromfeet tofeet
ype of completion (circle all applicable). Gravel pac	ked Underreamed Telescoped Open hole Natural Development
	r open note invatural Development
Con of lan nine or red with the set	scribe):
or or reduction in casing:	feet. If telescoped or more than one screen, describe on back of page
ogs run (circle all applicable): No log run Electric	Gamma Ray Density Sonic Neutron Other:
	Source Neutron Other:
ame of organization munication (	
alle of organization minning log(a).	
certify that the well was drilled, constructed, and co	ompleted in accordance with all applicable requirements of the Mississip
certify that the well was drilled, constructed, and co pepartment of Environmental Quality and/or the Mis	ssissippi Department of Health regulations and state laws
certify that the well was drilled, constructed, and co epartment of Environmental Quality and/or the Mis	ssissippi Department of Health regulations and state lowe
certify that the well was drilled, constructed, and co epartment of Environmental Quality and/or the Mis $\angle EEPER Dr; 11, aq # OC$	ssissippi Department of Health regulations and state lowe
certify that the well was drilled, constructed, and co epartment of Environmental Quality and/or the Mis $\angle EEPER Dr; 11, aq # OC$	2 79
certify that the well was drilled, constructed, and co epartment of Environmental Quality and/or the Mis	ississippi Department of Health regulations and state laws
certify that the well was drilled, constructed, and correspondent to the main of Environmental Quality and/or the Miss $\angle EEPER Dr; 11, aq \# Oc$	5 79 Signature of Water Well Contractor
certify that the well was drilled, constructed, and co epartment of Environmental Quality and/or the Mis $\angle EEPER Dr; 11, aq # OC$	2 79
certify that the well was drilled, constructed, and co epartment of Environmental Quality and/or the Mis $\angle EEPER Dr. 11, \neg 2 + Oc$	2 79 Signature of Water Well Contractor

If well telescopes please sketch below and show depths.

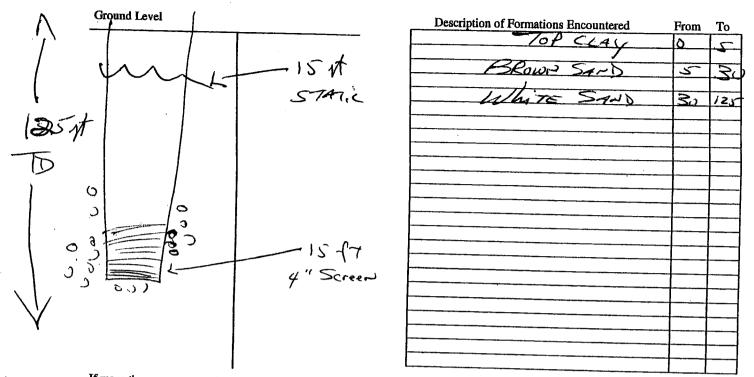

If more than one screen, show location of each on sketch

Sketch the property layout and include the following: 1) the well location; 2) any permanent structures on the property that may aid in locating the well; 3) any roads, power lines, or other items that may aid in locating the property and the well; Wel LANd. SCAPINE 47Ë And SCAPIN Art Landowner Name: obe Signature of Water Well Contractor RECEIVED MAY 18 2006

## BYOLWR

F- 168

<i>L</i>	STATE \	<b>WELL REPORT</b>	
County:Afayet		Part 2	For Office Use Only
Permit #:		ler's Completion Report ment of Environmental Quality	Aquifer: Well #: <b>F - 168</b> Blevation:
		nd and Water Resources	
		O. Box 10631 n, MS 39289-0631	
		601)961-5210	
/TTR. 4	(60)		
installation of pump.	ared by the pump installer in d	etail and filed with the Departme	nt within 30 days of the
Well Owner Information		Well Location	
Owner Name: Rober	I LAMPTON		
Mailing Address:	/	Latitude:	
		Method of Lat/Long (circle or	ne): Conventional Survey,
<u>۲</u>		USGS quad, Hand	1-held GPS, Survey-grade G
MACKSO	State Zip Code	<sup>1</sup> /4 <sup>1</sup> /4 Sec <u>1</u> /2 Twn <u></u> (S <sup>1</sup> /2 <sup></sup>	
Otity	State Zip Code	,	Twn 2 Rng 5
T11 - 41 03	2	Distance Direction	Nearest Town
Telephone No. (66) 93	3 3325	UZ_Miles_W_o	E OXL
Pump Circl	o Type e one		wer Type
11.710		Ci	rcle one
Jei	Submersible	Diesel Engine Gasolin	e Engine Natural (
Bucket Piston	Turbine	Electric Motor Hand	-
Centrifugal Rotary	Flowing Well		Tractor P
	-		specify):
Other (specify):		Horse Power Rating of Motor:	1+1P
Date Pump Installed:4_2	0-06	Setting Depth:	
Rated Pump Capacity:			5
		Number of Stages:	<u> </u>
Pump Te	est Data	Method of Mar	
Date Well Tested: 4-2	20	Cir	suring Water Level cle one
		Air Line Electric Measure	
Static Water Level (A):			( **
Pumping Water Level (B):	Feet Below Land Surface	Other (specify):	
Drawdown [(B) – (A)]:	Feet Below I and Surface	For flowing 1	
Test Pumping Rate:		For flowing well, measured shu	
		Well yielded	GPM with a drawdown of
Duration of Pump Test (minimum	4 hours):hours	feet after	hours of pumpi
		L	
I HEREBY CERTIFY that the above	ve statements are true to the Local	of my knowled	<u></u>
_ Leeper Dri	11:1, # 00 7G	or my knowledge.	7
Print Name of Pump Installer and L	icense No. (if annlicable)	-12	eper c
		Bignature of Pump Inst	allér (
		1.	
			A THE REP THE WAY

• •