
	- State V	Vell Report	
County: 64-Gallette		Part 1	For Office Use Only:
Permit #:		ent of Environmental Quality	Aquifer:
	Office of Land	and Water Resources	Well #: F- X 12
Driller: Leeper Drilling		Box 10631 MS 39289-0631	Well #:
Date drilling completed: <u>5-30-06</u>	(601)961-5210	L. S. Elevation:
· · · · · · · · · · · · · · · · · · ·	(601)3	54-6938 (fax)	E-log #:
State Law requires that this rep 30 days of completion of drilling	ort be prepared by the	e driller in detail and filed w	
Well Owner Informa	ation		
Owner Name_Brian der	اس الماد و		Location
Notice All R.		Latitude:''	" Longitude:°'
Mailing Address: P.D. Box 3.	460	Method of Lat/Long (circle on	e): Conventional Survey,
		USGS quad, Hand-held	GPS, Survey-grade GPS
City Star	te Zip Code		Twn 85 Rng 3W
Telephone No. (662) 8/6 - 5708	/	Distance Direction	Nearest Town
	Well 1	Data	
Purpose of Well (circle ond Home) Indu	ustrial Public Supply	T I I I	
Date well drilling started:		rigation Fish Culture	Other:
Date well drilling started: 9-30	Date v	well drilling completed:	30-06
in nowing, method of flow regulation: Valv	ve Other (d	escribe)	
Static Water Level: <u><u>90</u> feet abo</u>	ove or below (circle one) 1	and ourface Det	10 2 1
Method of Measurement (circle one) ste	cel tape, electric tape	air line other:	
Hole depth: <u>160 ft</u> Well dept	th: 160 pt	Well grouted to a depth of	10 feet
Type of grout (circle one): Cement	Bentonite Mix		
Casing length: 145_feet Casing	g diameter:4 "	_inches Type of casing:	PUC
Screen length: 15 feet Screen	diameter: <u>4</u> 4	_inches Type of screen:	Ve
screen slot size: <u>• 0 / 0</u> inches	Setting depth: From	145 feet to 160	feet
Type of completion (circle all applicable):	Gravel packed Underre		
			le Natural Development
fon of lan nine or reduction to the	- mer (ueseride):		
Fop of lap pipe or reduction in casing:	feet. If tele	scoped or more than one screer	, describe on back of page
logs run (circle all applicable): No log run	Electric Gamma Ray	Density Sonic Neutron Ot	
ame of organization running log(c).			
certify that the well was drilled, construct	ted, and completed in acc	cordance with all applicable and	
Department of Environmental Quality and	/or the Mississippi Depar	rtment of Health regulations on	d state land
		and a contractions and	u spate 18WS.
/ Pen- N III	# an Ta		
	#0079	1 The	
Print Name of Water Well Contractor and Lic	#0079	Signature of W	

.

8 COMP

F-Sx 171

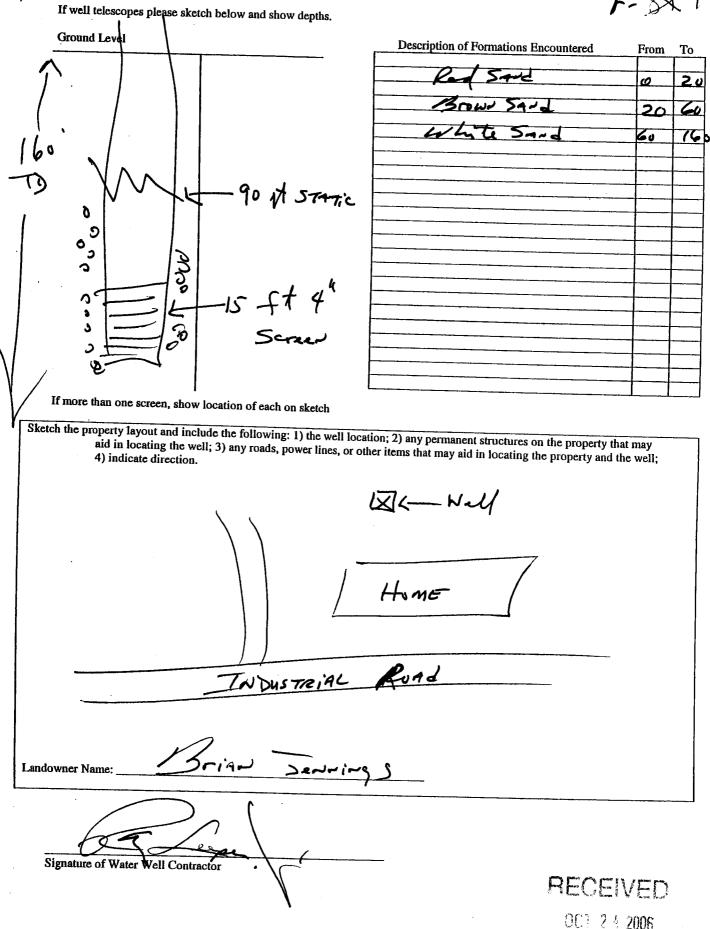

BYOLWR

County: Lafayette	Pump Installer's Cor		For Office Use Onl	
Permit #: Office of Lar		Environmental Quality	Aquifer:	
		Vater Resources		
Date completed: _/0- 2-06	Jackson, MS 39 (601)961-3	289-0631	Well #: F -	
		3210 38 (fax)	Elevation:	
This report should be prepared by the installation of pump.	– he pump installer in detail and	I filed with the Departmen	t within 30 days of the	
Well Owner Informa	tion		Location	
Owner Name: Briga de.	שרוריך ג			
Mailing Address: P.O. Box	241	titude:		
	Me	thod of Lat/Long (circle one	e): Conventional Survey,	
OXEDM	2		held GPS, Survey-grade (
City State	S Zip Code	¼¼ Sec/	Twn 85 Rng 3	
	Disi	tance Direction	Nearest Town	
Telephone No. 662, 816 - 3	708 14	12 Miles North of DXC		
Ритр Туре			- (
Circle one			er Type cle one	
Air Lift Jet	Submersible			
Bucket Piston			Engine Natural	
Centrifugal Rotary			Tractor F	
Other (specify):			pecify):	
Date Pump Installed: $10 - 2 - 0^{10}$	Hors	e Power Rating of Motor: _	12	
	Setti	ng Depth: / Z_(2feet	
Rated Pump Capacity: <u>20</u>	Gallons Per Minute Num	ber of Stages: //		
Pump Test Data				
Date Well Tested:	. 6	Method of Meas Circ	uring Water Level le one	
		ine Electric Measu	ring Line Steel Tape	
Static Water Level (A): <u>70</u> Fee Below Land Surface		r (specify):		
Pumping Water Level (B):Feet B				
Drawdown [(B) – (A)]:Feet I	1	lowing well, measured shut	in head:fe	
Cest Pumping Rate:Gallons Per Minute		yielded		
Duration of Pump Test (minimum 4 hours): _		feet after		
			or pump	
HEREBY CERTIFY that the above stateme	ents are true to the best of my kn		1	
Leeper Drilling #	00 79	The first		
Print Name of Pump Installer and License No	o. (if applicable)	Signature of Pump Insta	ller	
•		· · · · · · · · · · · · · · · · · · ·	VHECE	
			901-24	