State V	Vell Report	
	Driller's Log For Office Use Only:	
1 Mississippi Departme		
	nt of Environmental Quality and Water Resources Box 2309 Aquifer: Well #: F- 187	
1 5 11 1	n MS 30225	
Date drilling completed: 1-20-09 (601)	961- 5210 L. S. Elevation:	
(601)96	:1- 5228 (fax) E-log #:	
State Law requires that this report be prepared by the license holder responsible for the work and filed with the		
Department at the above address within 30 days of completion of drilling of the well or borehole.		
Information on Well Owner	Well or Borehole Location	
(Landowner if borehole is not for a water well)	Latitude: 34 . 22 , 883" Langitude: 89 . 30 , 426,	
Owner Name Air and Heat Service	Latitude: 34 ° 20 , 883" Longitude: 89 ° 30 , 426, Method of Lat/Long (circle one): Conventional Survey,	
·	Method of Lat/Long (circle one): Conventional Survey,	
Mailing Address: 415 pork drive	USGS quad, Hand-held GP3, Survey-grade GPS	
20055	NW 14 NW 14 Sec 22 Twn 85 Rng 3 W	
Oxford M3 38655 City State Zip Code	Distance Direction Nearest Town	
	3/4 Miles Sw of hwy 30 ml hwy)	
Telephone No. (<u>(くう)・ 838 - 8088</u>		
Wall / Roys	hole Date	
(ス- QE-28 Well / Borehole Data		
Date drilling started: Date drilling completed:	9 Hole depth: $230'$ Hole diameter: 5	
Location of the source of any surface water used for drilling: NA Method of dosing and volume of Chlorine used in drilling and development:		
Logs run (circle all applicable) No log run Electric Gamma Ray Density Sonic Neutron Other: Name of organization running log(s):		
Purpose of borehole (check one): Water Well Geotechnical/Geological Investigation Ground Source Heat Pump		
Seismic Survey Other (describe)		
If drilling is not related to water well construction, skip the remainder of this block		
Purpose of Well (check one): Home Industrial Public Supply Irrigation Fish Culture Other:		
If a flowing well, method of flow regulation: Valve Other (describe)		
Static Water Level:feet above or below (circle one) land surface		
Method of Measurement (circle one) steel tape electric tape air line other:		
Well depth: Well grouted to a depth offeet Type of grout (circle one): Neat Cement Bentonite Mix		
Casing length:feet Casing diameter:inches Type of casing:		
Screen length:feet Screen diameter:	inches	
Screen slot size:inches Setting depth: From	feet tofeet	
Type of completion (circle all applicable): Gravel packed Under	reamed Telescoped Open hole Natural Development	
Other (describe):		
Top of lap pipe or reduction in casing:feet. If telescoped or more than one screen, describe on next page		
Form: OLWR-SWR-1A (04/08)		

RECEIVED

JAN 28 2009


BY: OLWR

The sketch below only required for water wells

If well telescopes, show depths on sketch. Ground LevelDescription of formations encountered must be provided for all wells and boreholes, unless specifically exempted by regulations

Description of Formations Encountered	From (depth)	Γο (depth)
leg 200d	Ground Level	U
red clay	1.5	40
white sould	40	930
	1	
	İ	

If more than one screen, show location of each on sketch

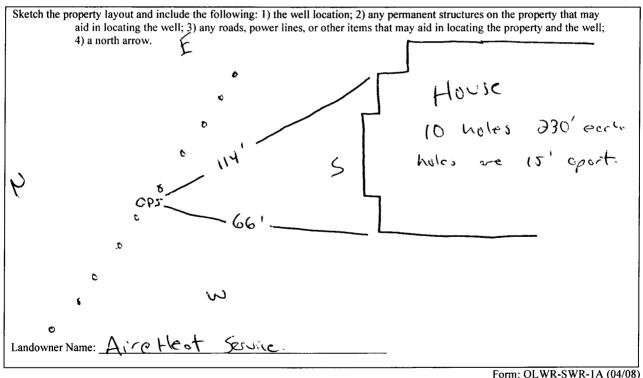

I certify that the well/borehole was drilled, constructed, and completed in accordance with all applicable requirements of the Mississippi Department of Environmental Quality and the Mississippi Department of Health regulations, if applicable, and state

laws.

Print Name of Responsible Licensee and License No.

Date

Signature of Licensee

RECEIVED

JAN 28 2009

BY: OLWR