	State Well Repo	r- <i>t</i>		
County: 24 fayetle	Part 1	For Office Use O A		
Permit #:	Mississippi Department of Environm	ron Onice Use Only;		
	Office of Land and Water Res	mental Quality Aquifer: F 190		
Driller: Leeper Drilling	P.O. Box 10631	Wall H.		
Date drilling completed: 3-1-10	Jackson, MS 39289-063	Well #:		
	(601)961-5210	L. S. Elevation:		
	(601)354-6038 (for			
State Law requires that this repo	of he prepared to the	E-log #:		
SU days of completion of drilling	of the well.	B-log #: ail and filed with the Department within		
Well Owner Informa	tion			
Owner Name HAZel CAM	bill ou	Well Location Latitude: 34.23.59 "Longitude: 29.28.55 "		
Mailing Address	Latitude: 54	· Co. 29 "Longing 29 7.9 55		
Stadices. CM4rger LA	Mailing Address: Charger LANE Latitude: 34			
•	Method of La	/Long (circle one): Conventional Survey,		
DVIIM		lad. Hand-held GDg. c		
City City	- INU 66	ad, Hand-held GPS, Survey-grade GPS		
City State	Zip Code	_ 14 Sec Twn_ <u></u> X Rng_ <u>3</u> W		
Telephone No. Clar 236 - 4	909 Distance	Direction		
		s A E of a l		
	Well Data	Direction Nearest Town s A E of 3 X for d		
Purpose of Well (circle one) Home Indus				
Date well drilling started: $3 - 1 - 10$ If flowing, method of flow regulation: Valve	trial Public Supply Irrigation F	ish Culture Other		
Sale went drilling started: $\leq 1/2/3$	Date well 1 tot			
If flowing, method of flow regulation: Valve Static Water Level:	Date well drilling comp	leted:		
alve	Other (describe)			
Static Water Level: 140 feet above				
Static Water Level: <u>140</u> feet abov Method of Measurement (circle one) steel	or below (circle one) land surface Da	te measured: $\gtrsim 2 - 10$		
Method of Measurement (circle one) steel	tape 2 electric tape			
Hole depth: <u>210</u> Well depth: Type of grout (circle one): Cement		other:		
Type of mout ( :	Well grouted to	a depth of $(1)$		
Type of grout (circle one): Cement I	lentonite (Mix)	feet		
Casing length, 190				
······································	iameter: 4 ", inches Type	of casing: PV C		
Screen length: <u>20</u> feet Screen d	14			
Creen slot eizer · 0 / 5		of screen: PVC		
	Betting denth. Brow / C	· · · · · · · · · · · · · · · · · · ·		
Type of completion (circle all applicable): Gr		et tofeet		
		ed Open hole Natural Development		
0				
op of lap pipe or reduction in casing.	her (describe):			
6	feet VEtoland a			
ogs run (circle all applicable): No log run E Iame of organization running log(s);	lectric Gamma Ray Danity	below, describe on back of page		
ame of organization running log(s):	Source Ray Density Sonic	Neutron Other:		
certify that the well was drilled constructed		-		
epartment of Environmental Quality and/or	, and completed in accordance with all	applicable requirements of the bar		
		regulations and starts of the Mississippi		
Leeper Drilling # 0	75	amatons and state laws.		
- eper Urilling		$5 \leq / \langle \rangle $		
rint Name of Water Well Contractor and Licen	se No.	XXXX		
		ignature of Water Well Contractor		
		DREHER		
		MAR 2 6 2010		
		PIMBLE & GUID		


1

BY: OLWP

If well telescopes please sketch below and show depths.

	If well tel	escopes p	lease ske	etch below and show depths.	L	= 190	
٠	Ground L	evel	1			11-	
	$\Lambda$	<u> </u>	<u>+</u>	1	Description of Formations Encountered	l From	То
,				1	Red Clay		10
	V I				Baulest		
	1. rel		b,	L-140 1+		10	100
2	10pr	V	۶V	= = 170 fl = STATIC Level	White Sand	100	210
	19 7	ć	)	=STATIC			
	Y 8	2	$\mathbf{X}$	Leel			
	13		$\mathcal{S}$				
		=	04	-Gravel pick			
	Ŭ	$\Xi$	0	•			╂
		5	<b>b</b>				
	$\langle V \rangle$			2070			╂───┤
	$\checkmark$			4".013800			
				4" . 013 PUC Screen			╂───┦
	1						
	1						
			•				

If more than one screen, show location of each on sketch

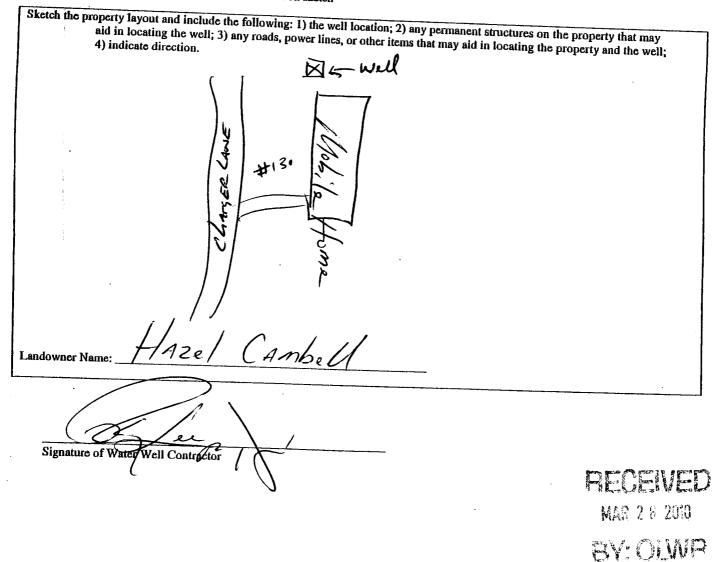

• • · · · · · · · · · · · · · · · · · ·	WELL REPORT
Driller: <u>22 par</u> <u>Driller</u> Date completed: <u>3-2-10</u> (60)	Part 2         aller's Completion Report         riment of Environmental Quality         and and Water Resources         2.0. Box 10631         on, MS 39289-0631         601)961-5210         1)354-6938 (fax)
installation of pump.	letail and filed with the Department within 30 days of the
Owner Name: AZe CAMBA Mailing Address: 30 Charger Lant Offord MS	Well Location Latitude:Longitude:Longitude: Method of Lat/Long (circle one): Conventional Survey, USGS quad, Hand-held GPS, Survey-grade GPS
City State Zip Code Telephone No. 662 236 - 4909	<u>4 4 Sec 11 Twn S Rng SW</u> Distance Direction Nearest Town <u>2 Miles NE of Oxford</u>
Pump Type Circle one         Air Lift       Jet         Bucket       Piston         Bucket       Piston         Centrifugal       Rotary         Flowing Well         Other (specify):         Date Pump Installed:	Power Type Circle one         Diesel Engine       Gasoline Engine       Natural Gas         Electric Motor       Hand       Tractor PTO         Windmill       Other (specify):
Rated Pump Capacity: / J Gallons Per Minute	Setting Depth:feet Number of Stages:/
Pump Test Data	
Date Well Tested: <u>S-2-10</u> Static Water Level (A): <u>(40)</u> Fee Below Land Surface Pumping Water Level (B):Feet Below Land Surface	Method of Measuring Water Level Circle one Air Line Electric Measuring Line Steel Tape Other (specify):
Drawdown [(B) – (A)]:Feet Below Land Surface Test Pumping Rate:Gallons Per Minute Duration of Pump Test (minimum 4 hours):hours	For flowing well, measured shut in head:fect Well yieldedGPM with a drawdown of fect afterhours of pumping
I HEREBY CERTIFY that the above statements are true to the best of Lee De Drilling # 007 9 Print Name of Pump Installer and License No. (if applicable)	Signature of Pump Installer
	MAR 2 8 2010
	BY: OLWR

.

.

· .

.