
County: LAGayette		Vell Report Part 1	For Office Use Only:
Permit #:	Mississippi Department of Environmental Quality		Aquifer:
Driller: Leeper Dr. 11,25	Office of Land and Water Resources		
		Box 10631 MS 39289-0631	Well #: F= 191
Date drilling completed: April 14 2013	(601	)961-5210	L. S. Elevation:
	(601)35	54-6938 (fax)	B-log #:
State Law requires that this repo 30 days of completion of drilling	ort be prepared by the	driller in dotoit and gues	
30 days of completion of drilling	of the well.	wither in detail and flied w	ith the Department within
Well Owner Information		Well Location	
Owner Name Iom TURNER Mailing Address: 720 Long Mendow		Latitude: 34 . 24 . 451	"Longinuda 89 8 20 1 Han
		Latitude: <u>34 • 24 · 251</u> " Longitude: <u>87 • 30</u> · <u>146</u> , Method of Lat/Long (circle one): Conventional Survey,	
Oxford MS 38655 City State Zip Code		USGS quad, Hand-held GPS, Survey-grade GPS $5E_{4} \underline{\text{MW}}_{4} \text{ sec}_{6} \underline{763}_{\text{Twn}} \underline{85}_{\text{Rng}} \underline{30}$	
City State Zip Code			
Telephone No. 662, 832. 61	95	Distance Direction	Nearest Town
	Well D		
Purpose of Well (circle one) Home Indu	strial Public Supply	Irrigation Fish Culture	<b>.</b>
Date well drilling started: 4-16-	(3	rish Culture	Other:
Date well drilling started: <u>4-16-1</u> If flowing, method of flow regulation: Valve	eOther (de	reaction)	
Static Water Level:		adille)	
Method of M	ve of below)(circle one) la	ind surface Date measured:	4-17-13
(stee	al tape ) electric tane	nin line in a	
Hole depth: 135 pt Well depth	h: 135 17	Well grouted to a depth of	/ C feet
e concili	Bentonite Mix)		
Casing length: _//5feet Casing	diameter:	1	Pilo
		_inches Type of casing:	<u>frc</u>
Screen slot size: <u>• 0 / 0</u> inches	diameter:	_inches Type of casing:	PVC
	Setting depth: From	.//5feet to13.	feet
Type of completion (circle all applicable):	Jravel packed Underrea	amed Telescoped Open ho	le Natural Development
	Other (describe):		Pullette
Top of lap pipe or reduction in casing:	fcet. If teles	scoped or more than one screen	describe on book of
Logs run (circle all applicable): No log run	Electric Gamma Ray	Density Sonta M	, ou back of page
Trailly Of Ofganization minning log(a).			
I certify that the well was drilled, construct Department of Environmental Quality and	ed, and completed in acc	Andanaa (1) 10	
Department of Environmental Quality and/	or the Mississinni Depar	tment of Health and Applicable req	uirements of the Mississippi
Leeper Villing #	0075	unent of Health regulations an	d state laws.
Print Name of Water Well Contractor and Lice	ense No.	Signature of W	
			APR 2 4 2013

BY: OLWR

F191

If well telescopes please sketch below and show depths.

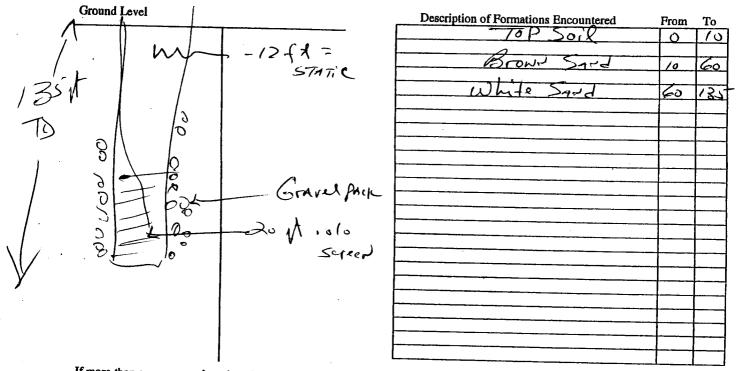

If more than one screen, show location of each on sketch

Sketch the property layout and include the following: 1) the well location; 2) any permanent structures on the property that may aid in locating the well; 3) any roads, power lines, or other items that may aid in locating the property and the well; Long Mendon Road 4 720 Bridge DITC Home -wU 0 m hrNER Landowner Name: Signature of Water Well Contractor RECEIVED APR 2 4 2013 BY: OLWR

STATE WELL REPORT				
County: <u>LAfayette</u> Permit #: <u>Driller: Leeper Dr.: 11</u> Date completed: <u>April 17 2013</u> This report in this	Pump Installa Mississippi Departn Office of Lan P.C Jackson (60)	Part 2 er's Completion Report nent of Environmental Quality ed and Water Resources D. Box 10631 MS 39289-0631 01)961-5210 354-6938 (fax)	For Office Use Only:   Aquifer:   Well #: F 19 ]   Elevation:	
This report should be prepared by the pump installer in detail and filed with the Department within 30 days of the				
Well Owner Information Owner Name: / 3 M Tu, Mailing Address: 72 J 200	on	4 Well	Location Longitude: $30$ , 144	
Oxford MS City State Telephone No. (62) 832 - 61			Twn <u>S</u> Rng <u>S</u> W	
Pump Type Circle one		Powe	г Туре	
Air Lift Jet	Submersible	Circ	le one	
Bucket	Turbine	Diesel Engine Gasoline I	Engine Natural Gas	
Centrifueal	Flowing Well		Tractor PTO	
Date Pump Installed:	allons Per Minute	Horse Power Rating of Motor: Setting Depth:/0 J Number of Stages:7	fcct	
Pump Test Data Date Well Tested:4-17-13		Method of Measur Circle	ring Water Level	
Static Water Level (A):Feet Below Land Surface Pumping Water Level (B):Feet Below Land Surface		Air Line Electric Measuria Other (specify):		
Drawdown [(B) (A)]:Feet Bel Test Pumping Rate:Ga Duration of Pump Test (minimum 4 hours):	ow Land Surface llons Per Minuto	For flowing well, measured shut in Well yieldedGH	PM with a drawdown of	
I HEREBY CERTIFY that the above statements Leeper Jr. Iling # 00 Print Name of Pump Installer and License No. (	179			
			APR 2 4 2013	
			BY: OLWF	