

County: Lafayette
 Permit #: _____
 Driller: Leapar Drilling
 Date drilling completed: 6-17-10

State Well Report

Part 1

Mississippi Department of Environmental Quality
 Office of Land and Water Resources
 P.O. Box 10631
 Jackson, MS 39289-0631
 (601)961-5210
 (601)354-6938 (fax)

For Office Use Only:
 Aquifer: _____
 Well #: F 200
 L. S. Elevation: _____
 E-log #: _____

State Law requires that this report be prepared by the driller in detail and filed with the Department within 30 days of completion of drilling of the well.

Well Owner Information

Owner Name: Rickey Bowen
 Mailing Address: 50 Industrial Rd
Industrial Park Dr
Oxford, MS 38655
 City State Zip Code
 Telephone No. (662) 832-1884

Well Location

Latitude: 34 24 30 Longitude: 89 29 56.4 ??
 Method of Lat/Long (circle one): Conventional Survey,
 USGS quad, Hand-held GPS, Survey-grade GPS
SW 1/4 SE 1/4 Sec 15 3 Twn 8 S Rng 3 W ?
 Distance Direction Nearest Town
1 Miles N of Oxford

Well Data

Purpose of Well (circle one) Home Industrial Public Supply Irrigation Fish Culture Other: _____
 Date well drilling started: 6-17-10 Date well drilling completed: 6-17-10
 If flowing, method of flow regulation: Valve _____ Other (describe) _____
 Static Water Level: 90 feet above or below (circle one) land surface Date measured: 6-18-10
 Method of Measurement (circle one) steel tape electric tape air line other: _____
 Hole depth: 150 ft Well depth: 150 ft Well grouted to a depth of 10 feet
 Type of grout (circle one): Cement Bentonite Mix
 Casing length: 130 feet Casing diameter: 4 inches Type of casing: PVC
 Screen length: 20 feet Screen diameter: 4 inches Type of screen: PVC
 Screen slot size: .013 inches Setting depth: From _____ feet to _____ feet
 Type of completion (circle all applicable): Gravel packed Underreamed Telescoped Open hole Natural Development
 Other (describe): _____
 Top of lap pipe or reduction in casing: _____ feet. If telescoped or more than one screen, describe on back of page
 Logs run (circle all applicable): No log run Electric Gamma Ray Density Sonic Neutron Other: _____
 Name of organization running log(s): _____


I certify that the well was drilled, constructed, and completed in accordance with all applicable requirements of the Mississippi Department of Environmental Quality and/or the Mississippi Department of Health regulations and state laws.

Leapar Drilling #0079
 Print Name of Water Well Contractor and License No.

[Signature]
 Signature of Water Well Contractor

RECEIVED
 JUL 06 2010
 BY: CJWR


If well telescopes please sketch below and show depths.

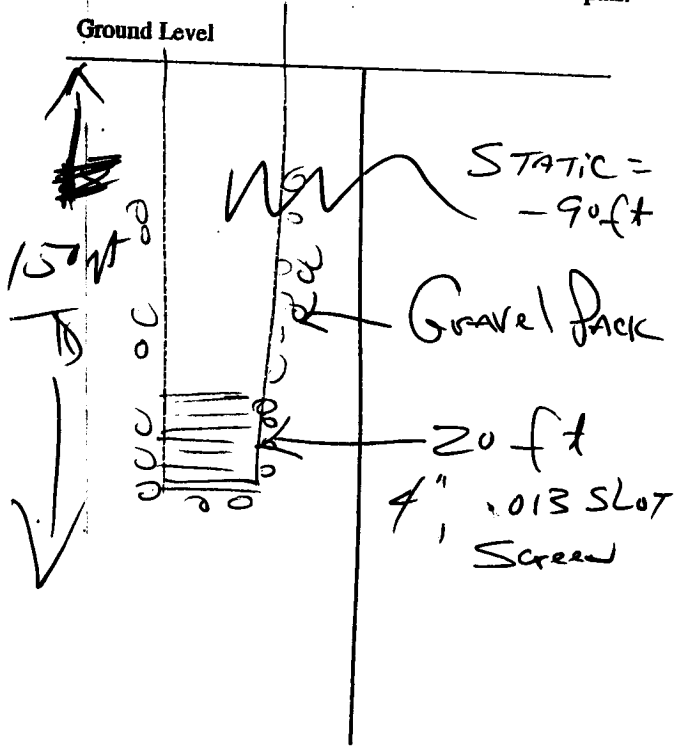

Description of Formations Encountered	From	To
Red clay	0	30
Brown sand	30	80
White sand	80	150

If more than one screen, show location of each on sketch

Sketch the property layout and include the following: 1) the well location; 2) any permanent structures on the property that may aid in locating the well; 3) any roads, power lines, or other items that may aid in locating the property and the well; 4) indicate direction.

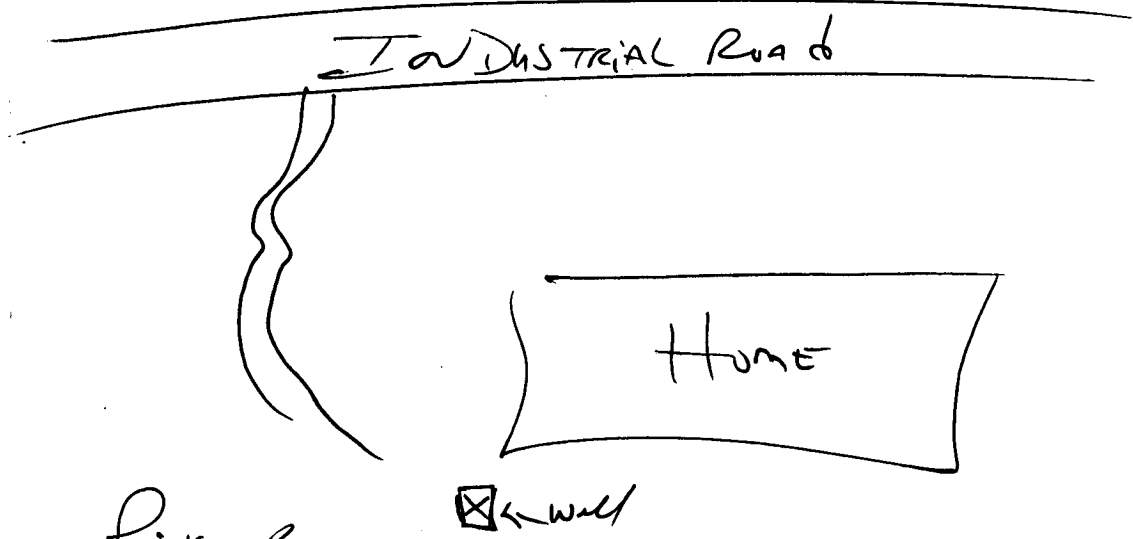

Landowner Name: Ricky Bowen

[Signature]
Signature of Water Well Contractor

RECEIVED
JUL 06 2010
BY: OLWR

STATE WELL REPORT

Part 2

Pump Installer's Completion Report
Mississippi Department of Environmental Quality
Office of Land and Water Resources
P.O. Box 10631
Jackson, MS 39289-0631
(601)961-5210
(601)354-6938 (fax)

For Office Use Only:

Aquifer: _____

Well #: F200

Elevation: _____

County: Lafayette

Permit #: _____

Driller: Zeeper Drilling

Date completed: 6/18/10

This report should be prepared by the pump installer in detail and filed with the Department within 30 days of the installation of pump.

Well Owner Information

Owner Name: Rickey Bower

Mailing Address: 50 Industrial Rd

Oxford, MS 38655
City State Zip Code

Telephone No. () _____

Well Location

Latitude: _____ Longitude: _____

Method of Lat/Long (circle one): Conventional Survey,

USGS quad, Hand-held GPS, Survey-grade GPS

S W 1/4 SE 1/4 Sec 15³ Twn 8 S Rng 3 W

Distance Direction Nearest Town

1 Miles N of Oxford

Pump Type Circle one

Air Lift Jet Submersible
Bucket Piston Turbine
Centrifugal Rotary Flowing Well

Other (specify): _____

Date Pump Installed: 6-18-10

Rated Pump Capacity: 20 Gallons Per Minute

Power Type Circle one

Diesel Engine Gasoline Engine Natural Gas
Electric Motor Hand Tractor PTO

Windmill Other (specify): _____

Horse Power Rating of Motor: 1 1/2 HP

Setting Depth: 140 feet

Number of Stages: 11

Pump Test Data

Date Well Tested: 6-18-10

Static Water Level (A): 90 Feet Below Land Surface

Pumping Water Level (B): _____ Feet Below Land Surface

Drawdown [(B) - (A)]: _____ Feet Below Land Surface

Test Pumping Rate: _____ Gallons Per Minute

Duration of Pump Test (minimum 4 hours): _____ hours

Method of Measuring Water Level Circle one

Air Line Electric Measuring Line Steel Tape

Other (specify): _____

For flowing well, measured shut in head: _____ feet

Well yielded _____ GPM with a drawdown of

_____ feet after _____ hours of pumping

I HEREBY CERTIFY that the above statements are true to the best of my knowledge.

Zeeper Drilling # 0079
Print Name of Pump Installer and License No. (if applicable)

[Signature]
Signature of Pump Installer

RECEIVED
JUL 06 2010
BY: OJWA