

LAFAYETTE

MISSISSIPPI BOARD OF WATER COMMISSIONERS

CODED

B G 2  
6-3-66

James R. Lipe  
WATER WELL DRILLERS LOG

Lafayette  
Linn


Date: 6, 3, 1966, Driller: Frank Deyton County: Linn  
(Name)

(1) Owner of Land:	Description & Color of Materials Sand, Clay, Red Clay, Shell, etc.	Thick- ness Feet	Depth Feet
McCoykel (Name) Oxford MISS. (Address)	Sand	0	180
(2) Location: 1/4, 1/4, Sec. 9 T8R2 10 miles east of Oxford (distance) (direction) (Nearest Town)			
(3) Topography: Hilly (Hilly) (Flat) (Level)			
(4) Purpose of Well: (Domestic, Irrigation, Municipal, Industrial, Other)			

Information upon completion of well:

- (1) Diameter 4 inches.
- (2) Total Depth 180 feet.
- (3) Water Level 130 feet below top of ground.
- (4) Cased to 180, Size 4"
- (5) Screen: Size 4", Length 8'
- (6) Were any formations sealed against pollution?  
\_\_\_\_\_ yes, \_\_\_\_\_ no.

If YES depth of formation \_\_\_\_\_  
Why \_\_\_\_\_  
Drillers Remarks: \_\_\_\_\_

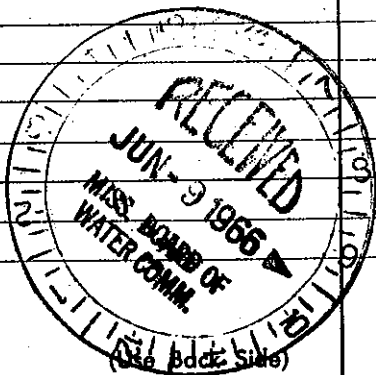

Well No.

Mail this copy to Board of Water Commissioners 429 Miss. St. Jackson, Miss