

L.A.F.
863
4-28-61

MISSISSIPPI BOARD OF WATER COMMISSIONERS

~~6-303~~

WATER WELL DRILLERS LOG

Date: 4-28, 1961, Driller: Elliott Harkins County: Wagoner
(Name)

(1) Owner of Land	Description & Color of Materials Sand, Clay, Red Clay, Shell, etc.	Thick- ness Feet	Depth Feet
<u>Walker Downs</u> (Name) <u>Albionville, Miss-PT</u> (Address)	<u>SAND + Clay-</u>	<u>40</u>	<u>40</u>
	<u>Clay</u>	<u>3</u>	<u>43</u>
(2) Location: <u>1/4, SE 1/4, Sec. 6 T8S24</u>	<u>SAND-</u>	<u>47</u>	<u>91</u>
_____ miles _____ of _____ (distance) (direction) (Nearest Town)			
(3) Topography: _____ (Hilly) (Flat) (Level)			
(4) Purpose of Well: _____ (Domestic Irrigation Municipal, Industrial, Other)			

Cased


Information upon completion of well:

- (1) Diameter 2" inches.
- (2) Total Depth 91 feet.
- (3) Water Level 60 feet below top of ground.
- (4) Cased to _____, Size _____
- (5) Screen: Size 2", Length 5'
- (6) Were any formations sealed against pollution?
_____ yes, _____ no.

If YES depth of formation _____

Why _____

Drillers Remarks: _____

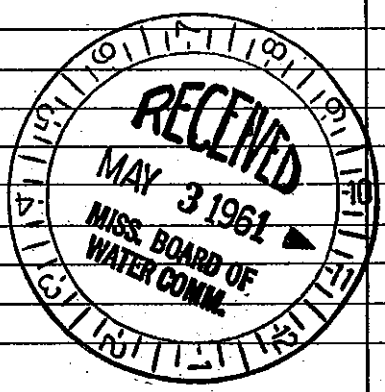

(Use Back Side)

Well No.

Retain this copy for your office files.