

MISSISSIPPI BOARD OF WATER COMMISSIONERS

LAF.

G7

5-9-62

WATER WELL DRILLERS LOG

Date: 5-9, 1962, Driller: Elliott Hardware County Lafayette

(Name)

(1) Owner of Land:	Description & Color of Materials Sand, Clay, Red Clay, Shell, etc.	Thick- ness Feet	Depth Feet
<u>L. C. Woods</u> (Name) <u>R.F.D #1 - Oxford, Miss</u> (Address)	<u>All Sand</u>	<u>139</u>	<u>139</u>
(2) Location: <u>1/4</u> , <u>1/4</u> , Sec. <u>9</u> T <u>25</u> N <u>24</u> <u>1</u> miles <u>North East</u> , of <u>Oxford</u> . (distance) (direction) (Nearest Town)			
(3) Topography: <u>Hilly</u> (Hilly) (Flat) (Level)			
(4) Purpose of Well: <u>Domestic</u> (Domestic Irrigation Municipal, Industrial, Other)			


Information upon completion of well:

- (1) Diameter 2 inches.
- (2) Total Depth 139 feet.
- (3) Water Level 95 feet below top of ground.
- (4) Cased to No, Size
- (5) Screen: Size 2", Length 6'
- (6) Were any formations sealed against pollution?
 yes, no.

If YES depth of formation _____

Why _____

Drillers Remarks: _____

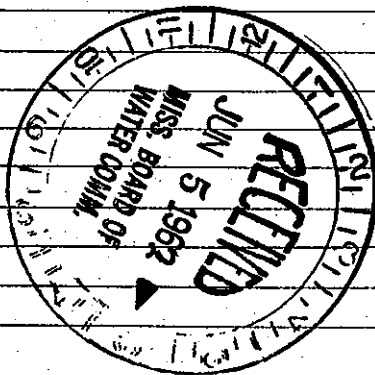

(Use Back Side)

Well No.

Retain this copy for your office files.