

LAF.

MISSISSIPPI BOARD OF WATER COMMISSIONERS

69

6-9-62

WATER WELL DRILLERS LOG

Date: 6/9, 1962, Driller: Elliott Hdwe Co County Lafayette
(Name)

(1) Owner of Land:	Description & Color of Materials Sand, Clay, Red Clay, Shell, etc.	Thick- ness Feet	Depth Feet
B.T. Starrock (Name) RFD #1 Oxford, Miss (Address)	Sand "Red"	47	47
(2) Location: 1/4, 1/4, Sec. 17 T8S, R2W	Clay white	2	49
8 miles East of Oxford (distance) (direction) (Nearest Town)	Sand	46	95
(3) Topography: Hilly (Hilly) (Flat) (Level)	Clay - "Pink"	1	96
(4) Purpose of Well: Domestic (Domestic Irrigation Municipal, Industrial, Other)			


Information upon completion of well:

- (1) Diameter 2" inches.
- (2) Total Depth 96 feet.
- (3) Water Level 60 feet below top of ground.
- (4) Cased to No, Size _____
- (5) Screen: Size 2", Length 6'
- (6) Were any formations sealed against pollution?
_____ yes, _____ no.

If YES depth of formation _____

Why _____

Drillers Remarks: _____

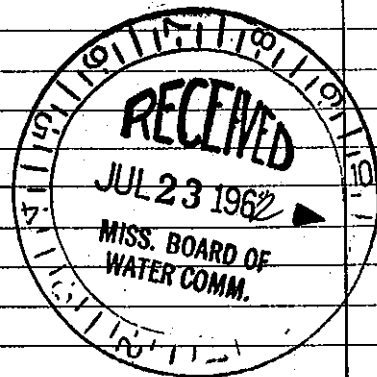

(Use Back Side)

Well No.

Retain this copy for your office files.