

LAF.
H1

MISSISSIPPI BOARD OF WATER COMMISSIONERS

5302

12-24-60

WATER WELL DRILLERS LOG

Date 12-24, 1960, Driller: Elliott H. Howe County LeFlore

(Name)

| (1) Owner of Land | Description & Color of Materials Sand, Clay, Red Clay, Shell, etc. | Thick- ness Feet | Depth Feet |
|--|---|-------------------------|--------------------------|
| (Name) <u>Eddy Bailey</u> <u>RT-1 - Oxford, Miss</u> (Address) | <u>Sand & Clay</u> <u>Sand</u> | <u>120</u> <u>10</u> | <u>120</u> <u>130</u> |
| (2) Location: <u>1/4, Sec. 6, R. 24</u> <u>10</u> miles <u>East</u> of <u>Oxford</u> (distance) (direction) (Nearest Town) | | | |
| (3) Topography: <u>Hilly</u> (Hilly) (Flat) (Level) | | | |
| (4) Purpose of Well: <u>Domestic</u> (Domestic Irrigation Municipal, Industrial, Other) | | | |


Information upon completion of well:

- (1) Diameter 7 inches.
- (2) Total Depth 130 feet.
- (3) Water Level 98 feet below top of ground.
- (4) Cased to _____, Size _____.
- (5) Screen: Size 2", Length 6 FT.
- (6) Were any formations sealed against pollution?
 yes, no.

If YES depth of formation _____

Why _____

Drillers Remarks: _____

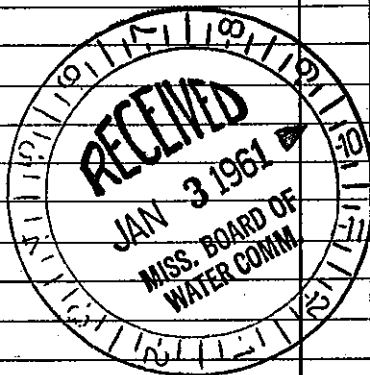

Well No.

(Use Back Side)

Mail this copy to Board of Water Commissioners 429 Miss. St. Jackson, Miss.