

CODED

LAFAYETTE
W 2 J10
11 -68

MISSISSIPPI
BOARD OF WATER COMMISSIONERS
416 North State Street
Jackson, Mississippi 39201

CODED

WATER WELL DRILLERS LOG

19 Paulk Brothers Lafayette
date well completed firm name county well located


LANDOWNER:	description of formations encountered	from	to
<u>Karl Brenkerk</u> <i>College of Engineering</i>	Red clay and sand	0	40'
<u>Colonial Rd.</u>	Sand and white clay	40'	120'
<u>Oxford, Miss.</u>	Grey clay w/some sand	120'	140'
<u>(mailing address)</u>	White med. sand	140'	194'

WELL LOCATION:
sec. 17 T 9 N R 11 E
5 miles Sw of Oxford
(distance) (direction) (nearest town)

WELL PURPOSE: home
(home, irrigation, municipal, industrial)

- WELL COMPLETION DATA:
- (1) diameter (inches) 2"
 - (2) total depth (feet) 194'
 - (3) static water level (feet) 116 below above top of ground.
 - (4) casing Steel 189
(material) (depth)
2" if telescope see back.
(size)
 - (5) screen 5' 189
(length) (depth to top)
1 1/2" S. S.
(size) (material)
 - (6) pump 3/4 3
(HP) (yield gpm)
Electric
(type power)
 - (7) electric log No
(yes or no)
(organization running log)
 - (8) how well bottom plugged Well Point

CODED

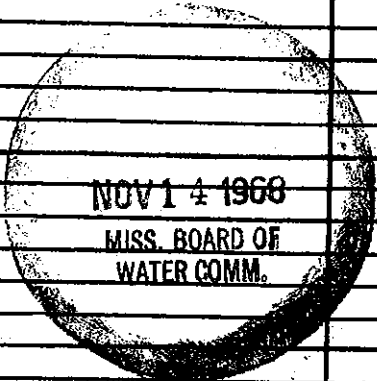

DRILLERS REMARKS: