

LAFAYETTE

J 13

MISSISSIPPI BOARD OF WATER COMMISSIONERS

6-14-62

WATER WELL DRILLERS LOG

**CODED**

Date: 6-14, 1962, Driller: H H Well Co

County: Lafayette


(Name): H H Well Co

(1) Owner of Land	Description & Color of Materials Sand, Clay, Red Clay, Shell, etc.	Thick- ness Feet	Depth Feet
(Name) J. G. Tolson R.F.D Taylor (Address)	Red clay	4	69
(2) Location: 1/4, 1/4, Sec. T. R.	Red sand	20	
2 95 SW 1/2 miles S.W., of (distance) (direction) (Nearest Town)	shaly white clay	8	
(3) Topography: (Hilly) (Flat) (Level)	White sand	4	
(4) Purpose of Well: (Domestic Irrigation) (Municipal, Industrial, Other)	Blue clay	20	
	Bol white sand		

Information upon completion of well:

- (1) Diameter 2 inches.
- (2) Total Depth 69 feet.
- (3) Water Level 14 feet below top of ground.
- (4) Cased to 63, Size 2
- (5) Screen: Size 1/4, Length 6
- (6) Were any formations sealed against pollution?  
yes, no.

#3 well  
0052 **CODED**  
Hand Pump

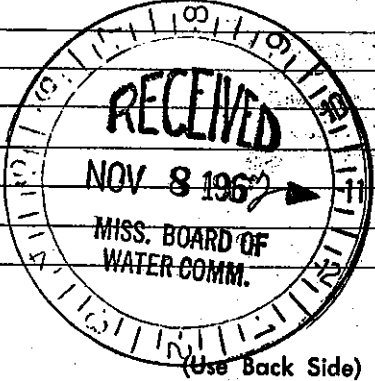

23 Well No.

Retain this copy for your office files.